


Give All Information Completely
Make Required Affidavit
Mail or Deliver Report to:
Conservation Division
State Corporation Commission
800 Bittling Building
Wichita, Kansas

15-009-16575-00-00
WELL PLUGGING RECORD

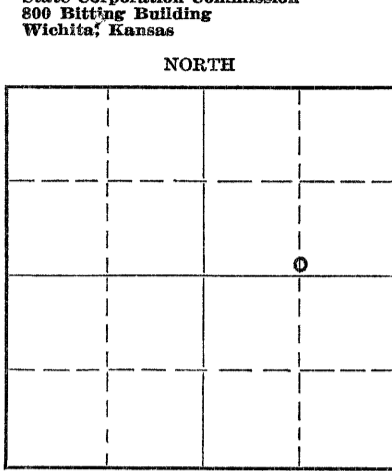

Locate well correctly on above Section Plat

Barton County, Sec. 19 Twp. 18S Rge. 15W (E) (W)
Location as "NE/CNW 1/4 SW 1/4" or footage from lines CS/2 S/2 NE
Lease Owner Bankoff Oil Company
Lease Name M. Bahr Well No. 1
Office Address P. O. Box 2301, Tulsa, Oklahoma
Character of Well (completed as Oil, Gas or Dry Hole) Abandoned Gas Well
Date well completed August 8, 1940 19
Application for plugging filed March 29, 1951 19
Application for plugging approved March 29, 1951 19
Plugging commenced April 12, 1951 19
Plugging completed April 17, 1951 19
Reason for abandonment of well or producing formation Gas depleted

If a producing well is abandoned, date of last production 19
Was permission obtained from the Conservation Division or its agents before plugging was commenced? Yes

Name of Conservation Agent who supervised plugging of this well C. D. Stough
Producing formation Depth to top Bottom Total Depth of Well 3510 Feet
Show depth and thickness of all water, oil and gas formations.

OIL, GAS OR WATER RECORDS

CASING RECORD

Formation	Content	From	To	Size	Put In	Pulled Out
				8-5/8"	943'	
				5-1/2"	3474'	1534'

Describe in detail the manner in which the well was plugged, indicating where the mud fluid was placed and the method or methods used in introducing it into the hole. If cement or other plugs were used, state the character of same and depth placed, from feet to feet for each plug set.

Dumped 8 sacks of cement on bottom of hole. Top of cement 3422 feet. Ripped off and pulled 1534 feet of 5-1/2 inch casing. Filled hole with mud to 940 feet. Set rock bridge and 10 sacks of cement at 940 feet. Mudded hole to 20 feet. Set bridge and 10 sacks of cement at the surface.

R & S Pipe Pulling Company - Pulling Contractors.

RECEIVED
STATE CORPORATION COMMISSION
MAY 21 1951
CONSERVATION DIVISION

(If additional description is necessary, use BACK of this sheet)
Correspondence regarding this well should be addressed to Bankoff Oil Company
Address P. O. Box 2301, Tulsa, Oklahoma

STATE OF Oklahoma, COUNTY OF Tulsa, ss.
Julius M. Bankoff (employee of owner) or (owner or operator) of the above-described well, being first duly sworn on oath, says: That I have knowledge of the facts, statements, and matters herein contained and the log of the above-described well as filed and that the same are true and correct. So help me God.

(Signature) Julius M. Bankoff
(Address) P. O. Box 2301, Tulsa, Okla.

SUBSCRIBED AND SWORN to before me this 19th day of May, 1951

My commission expires November 3, 1951 Notary Public.

PLUGGING
FILE SEC 19 T 18 R 15 W
BOOK PAGE 20 LINE 18


15-009-16575.00-00

OHIO OIL CO.
 Mary Bahr No. 1.

SEC.19 T.18 R.15W
 CSL NE

Total Depth. 3510'
 Comm. 7-12-40 Comp. 8-8-40
 Shot or Treated.
 Contractor. Sharon Drilg.Co.
 Issued. 8-31-40

County. Barton

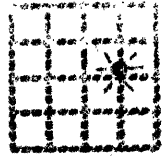

CASING:
 8 " 943'
 5 1/2 " 3474'

Elevation.

Production. 6,833,000 G.
 R.P. 653#

Figures Indicate Bottom of Formations.

sand	95
shale & shells	382
sand	463
shale & shells	505
shale	508
shale sdy	550
red rock	585
shale & shells	645
shale red	685
sand red	700
shale red	745
sand red	755
shale red	830
shale sdy	930
shale red	935
anhydrite	962
shale & shells	1365
shale & salt	1650
shale & shells	1790
shale	1850
shale & shells	1970
lime	2075
shale	2107
lime brkn	2158
lime	2180
shale	2190
lime	2345
shale	2355
lime	2435
shale & shells	2620
shale	2653
shale & shells	2763
lime	2805
shale	2835
lime	2850
shale	2900
shale V.C. & lime	2910
lime	3200
shale	3222
lime	3427
shale & lime	3458
shale V.C.	3462
shale green	3465
shale green & gy sdy	3470
sand & sand-chert Cong.	3484
sand	3510
Total Depth.	

See Bill...

PLUGGING
 FILE SEC-19 T-18 R-15W
 BOOK PAGE 70 LINE 18

APR - 2 1951
 COMMISSIONER'S DIVISION
 Wichita, Kansas