


WELL PLUGGING RECORD

Give All Information Completely  
Make Required Affidavit  
Mail or Deliver Report to  
Conservation Division  
State Corporation Comm.  
200 Colorado Derby Bldg.  
202 W. 1st St.  
Wichita, KS 67202

Rooks County Sec. 31 Twp. 9s Rge. 17  
Location as "NE/CNW/SW" or footage from lines  
SE SW SW  
Lease Owner Mark 111 Oil Inc.  
Lease Name Westhusing Well No. 2  
Office Address 211 West 36th Hays, Kansas 67601

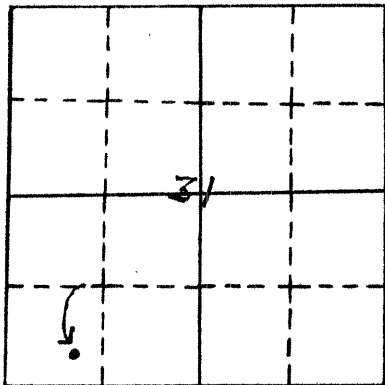

locate well correctly  
on above  
Section Plot

Character of Well (Completed as Oil, Gas or Dry Hole) Dry Hole  
Date Well completed 11-08 1982  
Application for plugging filed 11-08 1982  
Application for plugging approved 11-08 1982  
Plugging commenced 11-08 1982  
Plugging completed 11-08 1982  
Reason for abandonment of well or producing formation No Commercial Production

If a producing well is abandoned, date of last production 19    

Was permission obtained from the Conservation Division or its agents before plugging was commenced? Yes

Name of Conservation Agent who supervised plugging of this well Marion Schmidt  
Producing formation      Depth to top      Bottom      Tl. Depth of Well       
Show depth and thickness of all water, oil and gas formations.

OIL, GAS OR WATER RECORDS

CASING RECORD

FORMATION	CONTENT	FROM	TO	SIZE	PUT IN	PULLED OUT
Surface Casing	60-40 poz	0'	257'	8 5/8	257'	0'

Describe in detail the manner in which the well was plugged, indicating where the mud fluid was placed and the method or methods used in introducing it into the hold. If cement or other plugs were used, state the character of same and depth placed, from      feet to      feet for each plug set.

*Rec'd  
11-22-82*

- Plug #1 3300' with 20sxs
- Plug #2 1450' with 20 sxs
- Plug #3 1020' with 80 sxs
- Plug #4 270' with 40 sxs'
- Plug #5 40' with 10 sxs with 1/2 sxs. hulls  
10 sxs in rathole

P.D. @ 11:00P.M. 11-08-82


Total ----- 180 sxs 50-50 poz 6%gel 3% c

(If additional description is necessary, use BACK of this sheet)

Name of Plugging Contractor Pioneer Drilling Co. 308 W. Mill Plainville, Ks. 67663

STATE OF Kansas COUNTY OF Ellis, ss.

D. J. Markley (employee of owner) or (owner or operator) of the above described well, being first duly sworn on oath, says: That I have knowledge of the facts, statements, and matters herein contained and the log of the above described well is filed and that the same are true and correct. So help me God.

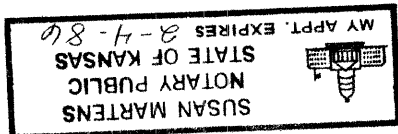

(Signature) D. J. Markley  
(Address) 2004 Vine Hays, Kansas 67601

SUBSCRIBED AND SWORN TO before me this 15 day of November, 1982

My commission expires February 4, '86

Susan Martens  
Notary Public