

STATE OF KANSAS
 STATE CORPORATION COMMISSION


Give All Information Completely
 Make Required Affidavit
 Mail or Deliver Report to:
 Conservation Division
 State Corporation Commission
 800 Bitting Building
 Wichita, Kansas

FORMATION PLUGGING RECORD

Strike out upper line
 when reporting plug-
 ging off formations.

Rocks _____ County. Sec. 16 Twp. 9S Rge. 17W (E) _____ (W) _____

Location as "NE $\frac{1}{4}$ NW $\frac{1}{4}$ SW $\frac{1}{4}$ " or footage from lines SE SE NW
 Lease Owner ALKAY OIL COMPANY
 Lease Name Yeagy Well No. 1
 Office Address 929 Kennedy Building
 Character of Well (Completed as Oil, Gas or Dry Hole) Oil Well
 Date, well completed November 12, 1946 193
 Application for plugging filed November 1, 1947 193
 Application for plugging approved _____ 193
 Plugging Commenced November 4, 1947 193
 Plugging Completed November 5, 1947 193
 Reason for abandonment of well or producing formation Production exhausted

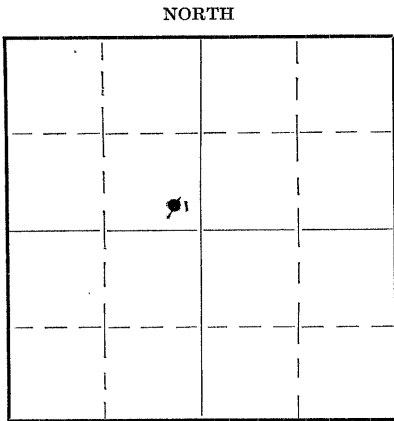

Locate well correctly on above
 Section Plat

If a producing well is abandoned, date of last production August 20, 1947 193
 Was permission obtained from the Conservation Division or its agents before plugging was com-
 menced? Yes

Name of Conservation Agent who supervised plugging of this well C. D. Stough
 Producing formation Kansas City Lime Depth to top 3228 Bottom _____ Total Depth of Well 3469 Feet.
 Show depth and thickness of all water, oil and gas formations.

OIL, GAS OR WATER RECORDS

CASING RECORD

Formation	Content	From	To	Size	Put In	Pulled Out
Kansas City Lime	Oil & Water	3228	3439	10 3/4"	1394	None
Ditto	Oil	3451	3465	7"	3451	2385

Describe in detail the manner in which the well was plugged, indicating where the mud fluid was placed and the method or methods used in introducing it into the hole. If cement or other plugs were used, state the character of same and depth placed, from _____ feet to _____ feet for each plug set.

- 3469 - T.D.
- 3469 - 3400 Heavy Mud
- 3400 - 3300 Plug and cement
- 3300 - 1100 Heavy Mud
- 1100 - 1060 Plug and cement
- 1060 - 175 Heavy Mud
- 175 - 155 Cement and plug
- 155 - 75 Mud
- 75 - 0 Cement

Received
Nb/28/47
28/11/47

(If additional description is necessary, use BACK of this sheet)


Correspondence regarding this well should be addressed to ALKAY OIL COMPANY
 Address 929 Kennedy Building - Tulsa, Oklahoma

STATE OF OKLAHOMA, COUNTY OF TULSA, ss.
Frank O. Bennett (employee of owner) or ~~representative~~ of the above-described well,
 being first duly sworn on oath, says: That I have knowledge of the facts, statements, and matters herein contained and the log of the above-
 described well as filed and that the same are true and correct. So help me God.

(Signature) Frank O. Bennett
929 Kennedy Building - Tulsa, Oklahoma
 (Address)

SUBSCRIBED AND SWORN to before me this 26 day of November, 1947

My commission expires Dec. 13, 1947
W Otis Smith
 Notary Public.

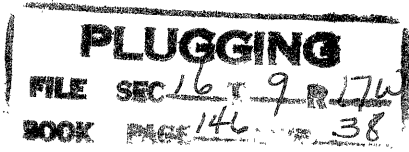

ALKAY OIL COMPANY

NO. 1 YEAGY

SE-SE-NW 16-9S-17W

ROOKS COUNTY, KANSAS

Commenced: 6-26-46
 Completed: 7-9-46
 I.P. 32 Bbls Oil - 50% water
 Effective 11-12-46

0 - 30	Clay
30 - 75	Lime & Shale
75 - 325	Lime & Shells
325 - 460	Shale
460 - 780	Shale & Shells
780 - 900	Sand & Shale
900 - 1114	Sand
1114 - 1384	Red Rock
1384 - 1421	Anhydrite
1421 - 1575	Red Rock
1575 - 1587	Shale & Salt
1587 - 1770	Shale
1770 - 2996	Lime & Shale Topeka 2996'
2996 - 3015	Lime - gray
3015 - 3045	Lime - white, soft
3045 - 3060	Lime & Shale
3060 - 3168	Lime
3168 - 3175	Lime - soft
3175 - 3189	Lime & Shale
3189 - 3194	Lime - saturation
3194 - 3203	Lime
3203 - 3211	Shale
	Dodge 3211'
3211 - 3222	Lime - white
3222 - 3224	Lime - soft, slight spotted saturation
3224 - 3228	Red Rock & Shale
	Kansas City @ 3228'
3228 - 3231	Lime - gray - few pieces, slight saturation
3231 - 3248	Lime & Shale
3248 - 3254	Lime - slight spotted saturation
3254 - 3288	Lime
3288 - 3296	Lime, some saturation probably carries water
3296 - 3297	Lime
3297 - 3302	Lime - saturation, no porosity
3302 - 3304	Lime
3304 - 3306	Lime - slight saturation
3306 - 3312	Lime
3312 - 3318	Lime - slight saturation
3318 - 3348	Lime & shale
3348 - 3354	Lime, fair saturation, water?
3354 - 3386	Lime
3376 - 3402	Lime - red rock & shale
3402 - 3404	Chert
3404 - 3409	Lime
3409 - 3425	Lime, fair saturation, poor porosity
3425 - 3432	Lime & shale
3432 - 3439	Lime - soft, porosity - water
3439 - 3446	Lime
3446 - 3451	Lime
3451 - 3465	Lime - soft, rich saturation & porosity
3465 - 3469	Lime
3469	Total Depth. SIM 3472 - 3469

PLUGGING
 FILE SEC 16 T 9 R 17W
 BOOK PAGE 146 OF 38

ALKAY OIL COMPANY, No. 1 Yeagy, SE-SE-NW 16-9S-17W, Rooks County, Kansas.

Drilled plug and cleaned out to bottom. Small show of oil. Set for 36 hours - tested 1 barrel of oil and one gallon of water.

Acidized with 4600 gallons.

Casing Record

10 3/4" - 1394' Cemented
7" - 3451' Cemented

NOV 28 1947