

**Give All Information Completely
Make Required Affidavit
Mail or Deliver Report to:
Conservation Division
State Corporation Commission
800 Bitting Building
Wichita, Kansas**

15-163-00074-00-01

			•

800 Bitting Building
Wichita, Kansas

NORTH

Locate well correctly on above
Section Plat

Rocks

County. Sec. 16 Twp. 9 Rge. 17 (E) (W) X

Location as "NE/CNW $\frac{1}{4}$ SW $\frac{1}{4}$ " or footage from lines

Lease Owner West Supply Co

Lease Name Carmichael Well Well No. 1

Office Address Box 506, Chase, Kansas

Character of Well (completed as Oil, Gas or Dry Hole)

Date well completed 4/11/50 19

Application for plugging filed 19

Application for plugging approved 19

Plugging commenced 4/6/50 19

Plugging completed 4/11/50 19

Reason for abandonment of well or producing formation

If a producing well is abandoned, date of last production 19

Was permission obtained from the Conservation Division or its agents before plugging was commenced? yes

Name of Conservation Agent who supervised plugging of this well Stage

Producing formation Depth to top Bottom Total Depth of Well Feet

Show depth and thickness of all water, oil and gas formations.

CASING RECORD

[illegible]

Rocked hole to 3250
Run 7 sks cement
Mudded hole to 270
Set Rock bridge
Run 20 sks cement
Mudded hole to 20
Run 10 sks cement
Well complete.

Correspondence regarding this well should be addressed to.
Address.....

STATE OF Kansas, COUNTY OF Rice
H. L. Herbel (employee of owner) or (owner or operator) of the above-described well,
 being first duly sworn on oath, says: That I have knowledge of the facts, statements, and matters herein contained and the log of the above-described well as filed and that the same are true and correct. So help me God.


(Signature)

SUBSCRIBED AND SWORN TO before me this 22nd day of.

My commission expires December 5, 1950.

My commission expires December 5, 1950.

Elmer A. Schulke - - - Notary Public.

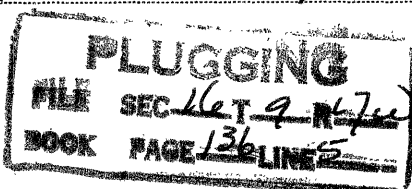

NYRA POOL

WELL RECORD

THE ATLANTIC REFINING COMPANY
830 Kennedy Building
Tulsa 3, Oklahoma

9S-17W

Block or Twp. 1
Well No. Kansas
State
Contracted Depth
Completed Depth
Location 50 ft. W. of Center of
SE SE NE of 16-9S-17W
Elevation 2078 Feet
Feet Workover 10-6-49
Feet Date { Started " " 10-7-49
Completed
Deepened
Cleaned Out

Lease Carmichael
Lease No. KS-8272
County Rooks
Drilled { Contract
Company Tools

Name of Contractor
Contract Price Per Foot Day Work
Well Estimated Cost
Well Actual Cost Method of Drilling

BEFORE SHOOTING

Initial Production
Settled Production
Baume Test
Flowing
on Pump
Water With Oil

AFTER SHOOTING

Initial Production
Settled Production
Flowing
on Pump
%

Casing Record

SIZE SET PULLED
(Previously reported)
10-3/4" 620' w/225 sax cement
7" Set at 3250' w/175 sax cement
5 1/2" Liner - Set 254' from 3192' to
3446' w/75 sax cement.

Torpedo Record

Date Company From To Feet Size of Shell Total Qts.

TOTAL DEPTH (Previously Reported) 3547 TD
3442 PBD

PRODUCING ZONE (Previously Reported) 3429 - 3431

WORKOVER STARTED 10-6-49. WORKOVER COMPLETED 10-7-49.

Pulled rods and tubing. Lane-Wells ran Gamma Ray Neutron Log to 3427 1/2. Hole filled up from 3442 - 3427 1/2. Examined tubing and could not find mud anchor. Fished mud anchor out of hole. Ran Gamma Ray from 3427 1/2 to 3443 (Lane-Wells checked TD at 3443. Company TD 3442.)

Perforated show at 3426 - 3428 w/16 Kone shots.

Ran rods and tubing to put back on pump.

TOTAL DEPTH: 3547 TD
3442 PBD (Lane Wells checked TD 3443)

PRODUCING AREA: 3426 - 3428 and 3429 - 3431

Received
1/29/50

PLUGGING
FILE SEC 16 T 9 R 17 W
BOOK PAGE 136 LINE 5