

STATE OF KANSAS
STATE CORPORATION COMMISSION


WELL PLUGGING RECORD

Give All Information Completely
Make Required Affidavit
Mail or Deliver Report to:
Conservation Division
State Corporation Commission
211 No. Broadway
Wichita, Kansas

Rooks County, Sec. 16 Twp. 9S Rge. 17W (XXXXXXX)

Location as "NE/CNW/SW" or footage from lines Approx C NW/4, NW/4, SE/4
Lease Owner Mahoney Drilling Company, Inc.
Lease Name Watkins Well No. 1
Office Address P. O. Box 1257, Liberal, Kansas 67901
Character of Well (completed as Oil, Gas or Dry Hole) Dry Hole
Date well completed 7-7 1968
Application for plugging filed 7-7 1968
Application for plugging approved 7-7 1968
Plugging commenced 7-7 1968
Plugging completed 7-7 1968
Reason for abandonment of well or producing formation Dry Hole

NORTH

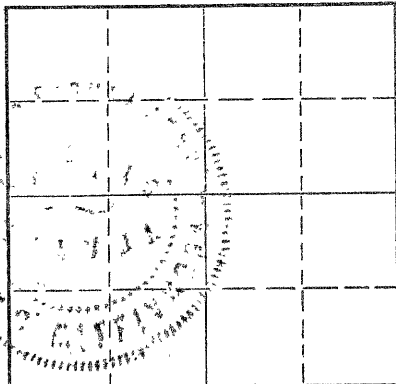

Locate well correctly on above
Section Plat

If a producing well is abandoned, date of last production 19
Was permission obtained from the Conservation Division or its agents before plugging was commenced? Yes

Name of Conservation Agent who supervised plugging of this well Leo Massey
Producing formation Depth to top Bottom Total Depth of Well Feet
Show depth and thickness of all water, oil and gas formations.

OIL, GAS OR WATER RECORDS

CASING RECORD

FORMATION	CONTENT	FROM	TO	SIZE	PUT IN	PULLED OUT

Describe in detail the manner in which the well was plugged, indicating where the mud fluid was placed and the method or methods used in introducing it into the hole. If cement or other plugs were used, state the character of same and depth placed, from feet to feet for each plug set.

3590 - 660 - Heavy rotary mud
660 - 660 - HB plug, 70 sacks 50-50 Posmex 6% jel
660 - 240 - Heavy rotary mud
240 - 240 - HB plug, 20 sacks 50-50 Posmex 6% jel
240 - 40 - Heavy rotary mud
40 - 40 - HB plug, 10 sacks 50-50 Posmex, 6% jel

RECEIVED
STATE CORPORATION COMMISSION
JUL 12 1968
CONSERVATION DIVISION
Wichita, Kansas

(If additional description is necessary, use BACK of this sheet)
Name of Plugging Contractor Peel Brothers, Inc.
Address Box 359, Hoisington, Kansas 67544

Peel Brothers, Inc., COUNTY OF Barton, ss.
(employee of owner) or (owner or operator) of the above-described


well being first duly sworn on oath, says: That I have knowledge of the facts, statements, and matters herein contained and the log of the above well as filed and that the same are true and correct. So help me God. PEEL BROTHERS, INC.

(Signature) Wendell C. Peel, President

(Address)

SUBSCRIBED AND SWORN TO before me this 9th day of July, 1968

My commission expires 6-21-70 Ethel S. Williamson Notary Public.

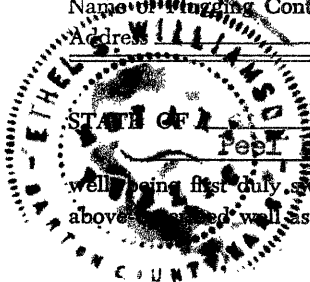

DRILLER'S LOG

Well Owner: Mahoney Drilling Company, Inc.
Farm Name: Watkins #1
Date Started: 6-29-68
Date Completed: 7-7-68
Total Depth: 3590

Section 16-9S-17W
Rooks County, Kansas

Casing: 8-5/8" set at 249' cemented

Contractor: Peel Brothers, Inc.

Figures below are the bottoms of the formations:

Clay	0 - 40
Red Bed	760
Sand	865
Sand, Shale and Shells	1110
Anhydrite	1437
Shale and Shells	1735
Shale and Lime	2490
Shale	2635
Lime and Shale	3110
Lime	3590
Total Depth	3590

RECEIVED
STATE CORPORATION COMMISSION
7/12/68
JUL 12 1968
CONSERVATION DIVISION
Wichita, Kansas

This is to certify that the above information is true and correct to the best of our knowledge.

PEEL BROTHERS, INC.

Wendell C. Peel
Wendell C. Peel
President



SUBSCRIBED AND SWORN to before me this 9th day of July, 1968.

Ethel S. Williamson
Ethel S. Williamson
Notary Public

My Commission expires 6-21-70