


STATE OF KANSAS
STATE CORPORATION COMMISSION

WELL PLUGGING RECORD

Give All Information Completely
Make Required Affidavit
Mail or Deliver Report to:
Conservation Division
State Corporation Commission
800 Bitting Building
Wichita, Kansas

Rooks County. Sec. 32 Twp. 9S Rge. 17 (E) (W) (W)
Location as "NE/CNW $\frac{1}{4}$ SW $\frac{1}{4}$ " or footage from lines SE SE SE/4
Lease Owner Strain Drilling Co.
Lease Name Williams Well No. #1
Office Address Box 188 Hays, Kansas
Character of Well (completed as Oil, Gas or Dry Hole) Dry Hole
Date well completed 12-5 1950
Application for plugging filed 12-5 1950
Application for plugging approved 12-5 1950
Plugging commenced 12-5 1950
Plugging completed 8:00 P.M. 12-5 1950
Reason for abandonment of well or producing formation Dry Hole

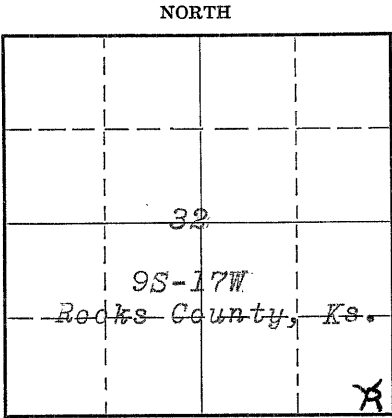

Locate well correctly on above Section Plat

If a producing well is abandoned, date of last production _____ 19____
Was permission obtained from the Conservation Division or its agents before plugging was commenced? Yes Verbal

Name of Conservation Agent who supervised plugging of this well Eldon Petty
Producing formation none Depth to top _____ Bottom _____ Total Depth of Well 3585 Feet
Show depth and thickness of all water, oil and gas formations.

OIL, GAS OR WATER RECORDS

CASING RECORD

Formation	Content	From	To	Size	Put In	Pulled Out
<u>Soil & shale</u>	<u>@</u>	<u>0</u>	<u>155</u>	<u>8 5/8"</u>	<u>155'</u>	<u>none</u>
<u>K. C. Lime</u>	<u>dry</u>	<u>3150</u>	<u>3527</u>		<u>none</u>	<u>none</u>
<u>Arbuckle Lime</u>	<u>dry</u>	<u>3559</u>	<u>3585</u>		<u>none</u>	<u>none</u>

Describe in detail the manner in which the well was plugged, indicating where the mud fluid was placed and the method or methods used in introducing it into the hole. If cement or other plugs were used, state the character of same and depth placed, from _____ feet to _____ feet for each plug set.

Stirred pits and filled hole with heavy mud. Placed bottom wood plug at 150' with 1 sack of Hulls on top of plug. Ran 15 sacks of cement through drill pipe on same.
Filled hole with heavy mud to 40' Placed top wood plug and 1 sack Hulls at 40' and ran 10 sacks cement through drill pipe, filling hole to bottom of cellar.

RECEIVED
STATE CORPORATION COMMISSION
12-13-50
DEC 13 1950
CONSERVATION DIVISION
Wichita, Kansas

(If additional description is necessary, use BACK of this sheet)

Correspondence regarding this well should be addressed to Strain Drilling Company.
Address Box 188, Hays, Kansas.

STATE OF Kansas, COUNTY OF Ellis, ss.
T.C. Strain (employee of owner) or (owner or operator) of the above-described well, being first duly sworn on oath, says: That I have knowledge of the facts, statements, and matters herein contained and the log of the above-described well as filed and that the same are true and correct. So help me God.

(Signature) T.C. Strain
Box 188, Hays, Kansas.
(Address)

SUBSCRIBED AND SWORN to before me this 12th day of December, 1950.

My commission expires March 1, 1954
Leroy R. Power Notary Public.

PLUGGING
FILE SEC 32T-9 R176
BOOK PAGE 47 LINE 42

Company: Strain Drilling Co.

Lease: Williams #1

Elevation: 2110 R.B.

SE SE SE Sec. 32-Twp. 9S
Rge. 17W,
Rooks County, Kansas.

0	35 Clay & soil
35	45 Hard lime
45	60 Hard lime
60	125 Shale & shells
125	155 Blue shale
155	780 Shale & shells
780	905 Shale, shells, & sand
905	930 Shale & shells
930	1090 Sand
1090	1350 Red bed & shale
1350	1375 Anhydrite
1375	1395 Anhydrite
1395	1500 Shale & Redbed
1500	1690 Shale & shells
1690	1850 Shale & shells
1850	1990 Lime & shale
1990	2185 Lime & shale
2185	2270 Lime & shale
2270	2350 Lime
2350	2440 Lime
2440	2510 Lime & shale
2510	2570 Lime & shale
2570	2600 Shale & shells
2600	2720 Shale & lime
2720	2870 Shale & shells
2870	3005 Shale & lime
3005	3080 Shale & lime
3080	3135 Lime & shale
3135	3200 Lime & shale
3200	3250 Lime & shale
3250	3285 Lime
3285	3335 Lime
3335	3400 Lime
3400	3435 Lime
3435	3475 Lime
3475	3515 Lime & shale
3515	3545 Lime & shale
3545	3560 Shale & sand
3560	3575 Lime (Arbuckle)
3575	3585 Arbuckle.
3585	T.D. rotary bushings.

COMMENCED: 11-25-50
COMPLETED: 12-5-50

RECEIVED
REGISTRATION COMMISSION
12-13-50
DEC 3 1950
DIVISION

Tops:

Anhydrite	1357	Arbuckle	3559
Heebner	3109	Show (heavy dead oil)	3563
K.C. Lime	3150	T.D.	3585

I hereby affirm that the above and foregoing is a true and correct copy of the log of the Williams #1, located SE SE SE/4 Sec. 32 Twp. 9S, Rge. 17W, Rooks County, Kansas.

PLUGGING
FILE SEC 32 T 9 R 17W
BOOK PAGE 47 LINE 4Y

Strain Drilling Company.

By T.C. Strain

T.C. Strain.