


APR 6 1983

STATE OF KANSAS
STATE CORPORATION COMMISSION
200 Colorado Derby Bldg.
Wichita, Kansas 67202

WELL PLUGGING RECORD

Give All Information Completely
Make Required Affidavit

COUNTY Roake SEC. 32 TWP. 9S RGE. 17 NW
Location as in quarters or footage from lines:
SE SE NW

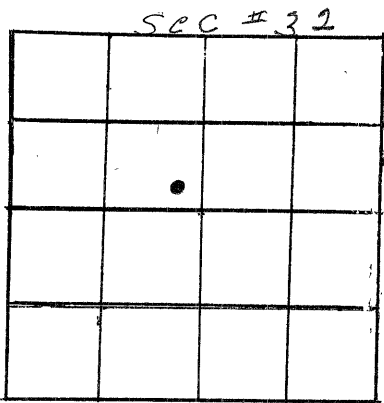

Locate Well
correctly on above
Section Platt.

Lease Owner PRICE EXPLOATION INC
Lease Name EADS Well No. 1
Office Address 412 MAYO BLDG TULSA OKLA 74104
Character of Well (Completed as Oil, Gas or Dry Hole):
Date Well Completed 12-15-1980
Application for plugging filed DEC 10, 1982
Plugging commenced JAN 15-1983
Plugging completed JAN 26th-1983
Reason for abandonment of well or producing formation Hole in
CSB - NO OIL
Was permission obtained from the Conservation Division or it's
Agent's before plugging was commenced? Yes

Name of Conservation Agent who supervised plugging of this well DENNIS HAMEL
Producing formation K-C Depth to top 3350 bottom 3555 T.D. 3585
Show depth and thickness of all water, oil and gas formations.

OIL, GAS OR WATER RECORDS

Casing Record

Formation	Content	From	To	Size	Put in	Pulled Out
<u>KC</u>	<u>oil</u>	<u>3430</u>	<u>3548</u>	<u>4 1/2</u>	<u>1-1-80</u>	<u>12</u>

Describe in detail the manner in which the well was plugged, indicating where the mud fluid was placed and the method or methods used in introducing it into the hold. If cement or other plugs were used, state the character of same and depth placed, from _____ feet to _____ feet for each plug set. Permanental bridge plug at 3145'

plug as follows: 4 sacks puller - 50 sack 50/50 polymer 690 gel
12 sacks bentonite 70 sacks 50/50 cement 8 sacks gel 70 sacks 50/50
cement.

RECEIVED
STATE CORPORATION COMMISSION


APR 07 1983
4-7-83

CONSERVATION DIVISION
Wichita, Kansas

(If additional description is necessary, use BACK of this sheet)
Name of Plugging Contractor _____

STATE OF Ks COUNTY OF Roake, ss.
Wayne E. Fuzzell (employee of owner) or (owner or operator) of the
above-described well, being first duly sworn on oath, says: That I have knowledge of the
facts, statements, and matters herein contained and the log of the above-described well as
filed and that the same are true and correct. So help me God.

(Signature) Wayne E. Fuzzell
200 S. Colo Plainwell, Kan
(Address) 07663

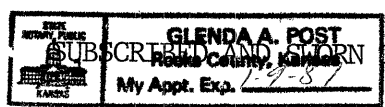

TO before me this 4 day of April, 19 83
Glenda A Post
Notary Public.

My Commission expires: 1-9-87