


STATE OF KANSAS
STATE CORPORATION COMMISSION

WELL PLUGGING RECORD

Give All Information Completely
Make Required Affidavit
Mail or Deliver Report to:
Conservation Division
State Corporation Commission
800 Biting Building
Wichita, Kansas

Rooks County, Sec. 32 Twp. 9S Rge. (E) 17 (W)

Location as "NE/CNW/SW" or footage from lines NE NE SE
Lease Owner Petroleum, Inc.
Lease Name WILLIAMS 'B' Well No. 1
Office Address 311 East 3rd, Wichita, Kansas
Character of Well (completed as Oil, Gas or Dry Hole) Dry Hole
Date well completed September 6 1955
Application for plugging filed September 6 1955
Application for plugging approved September 6 1955
Plugging commenced September 6 1955
Plugging completed September 6 1955
Reason for abandonment of well or producing formation Dry Hole

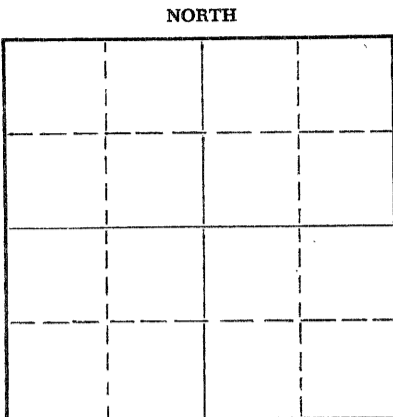

Locate well correctly on above Section Plat

If a producing well is abandoned, date of last production 19
Was permission obtained from the Conservation Division or its agents before plugging was commenced? yes

Name of Conservation Agent who supervised plugging of this well Mr. Eldon Petty, Hays, Kansas
Producing formation _____ Depth to top _____ Bottom _____ Total Depth of Well 3595 Feet
Show depth and thickness of all water, oil and gas formations.

OIL, GAS OR WATER RECORDS

CASING RECORD

FORMATION	CONTENT	FROM	TO	SIZE	PUT IN	PULLED OUT
				8-5/8"	205	None

Describe in detail the manner in which the well was plugged, indicating where the mud fluid was placed and the method or methods used in introducing it into the hole. If cement or other plugs were used, state the character of same and depth placed, from _____ feet to _____ feet for each plug set.

Mudded up with heavy mud to 200' and placed first plug with 1/2 sack hulls on top of plug followed by 15 sacks cement. Mud to 40' and placed 2nd plug at 40' with 1/2 sack hulls on top of plug followed by 10 sacks cement to base of well cellar.

(If additional description is necessary, use BACK of this sheet)

Name of Plugging Contractor Garvey Drilling Company
Address R. R. #2 - Great Bend, Kansas

STATE OF KANSAS, COUNTY OF SEDGWICK, ss.
Karl E. Becker (employee of owner) or (owner or operator) of the above-described well, being first duly sworn on oath, says: That I have knowledge of the facts, statements, and matters herein contained and the log of the above-described well as filed and that the same are true and correct. So help me God.

(Signature) Karl E. Becker
311 East Third, Wichita, Kansas
(Address)

SUBSCRIBED AND SWORN TO before me this 6th day of September, 1955

My commission expires August 8, 1959 Gilona Mowson Notary Public.

PLUGGING
FILE SEC 32 T 9 R 17W
BOOK PAGE 148 LINE 27

9-20-55

WELL LOG

COMPANY **Petroleum, Inc.**

SEC. **32** T. **9** R. **17W**

FARM **WILLIAMS 'B'** NO. **1**


LOC. **88 88 88**
130' P.M.
2310' P.M.

TOTAL DEPTH **3595'**

COUNTY **Woods**

COMM. **August 27, 1955** COMP. **September 6, 1955**

CONTRACTOR **Garvey Drilling Company**

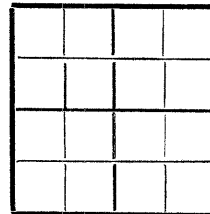

CASING **8-5/8" @ 235' w/150 cas**

ELEVATION **2113' ASL**
2111' DW

PRODUCTION **O & A**

FIGURES INDICATE BOTTOM OF FORMATIONS

205	Sand & Shale
600	Shale
660	Sand and Shale
820	Sand
910	Sand & Shale
1080	Sand
1375	Shale & Shells
1415	Anhydrite
1850	Shale & Shells
1915	Shale Linc
2175	Linc, Shale & Shells
2335	Linc
2510	Linc & Shale
2600	Shale
2660	Linc
2710	Shale
2970	Linc & Shale
3100	Linc
3510	Linc & Conglomerate
3595	Linc

R.T.D. 3595'

Geological Form

Topoket	3025	(- 892)
Hochmors	3221	(-1208)
Toronto	3238	(-1125)
Landing	3263	(-1100)
Conglomerate	3531	(-1118)
Dimpson	3557	(-1116)
Artichoke	3582	(-1169)

State of KANSAS }
County of SEDDWICK } SS :

PLUGGING
WELL SEC 32 T 9 R 17W
BOOK PAGE 148 LINE 27

I, Karl E. Becker of Petroleum, Inc.

upon oath state that the above and foregoing is a true and correct copy of the log of the WILLIAMS 'B' #1 well

Subscribed and sworn to before me this 16th day of September 19 55

My Commission Expires: August 8, 1959

Karl E. Becker
Notary Public