

STATE OF KANSAS  
STATE CORPORATION COMMISSION

WELL PLUGGING RECORD

Give All Information Completely  
Make Required Affidavit  
Mail or Deliver Report to  
Conservation Division  
State Corporation Comm.  
245 North Water  
Wichita, KS 67202

Rooks County, Sec. 3 Twp. 9S Rge. 18 E/W  
Location as "NE/CNW $\frac{1}{4}$ SW $\frac{1}{4}$ " or footage from lines  
NW SW SW


Lease Owner Cities Service Oil Co.  
Lease Name RICHARDSON "A" Well No. 1  
Office Address 209 E. William, 700 Sutton Place Bldg, Wichita  
Character of Well (Completed as Oil, Gas or Dry Hole)  
Dry Hole

Date Well completed 2-06 1977  
Application for plugging filed (Verbally) 2-06 1977  
Application for plugging approved (Verbally) 2-06 1977  
Plugging commenced 2-06 1977  
Plugging completed 2-06 1977

Reason for abandonment of well or producing formation  
No commercial quantity of oil or gas encountered  
If a producing well is abandoned, date of last production 19

Was permission obtained from the Conservation Division or its agents before plugging was commenced? Yes

Name of Conservation Agent who supervised plugging of this well Leo Massey  
Producing formation Depth to top Bottom Total Depth of Well  
Show depth and thickness of all water, oil and gas formations.

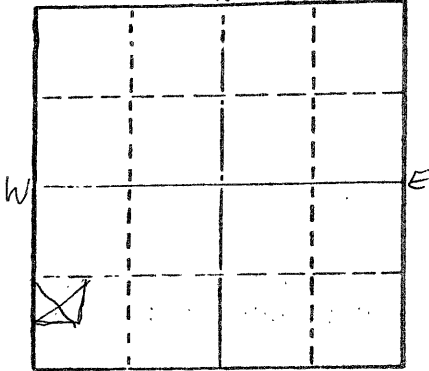

OIL, GAS OR WATER RECORDS

CASING RECORD

FORMATION	CONTENT	FROM	TO	SIZE	PUT IN	PULLED OUT

Describe in detail the manner in which the well was plugged, indicating where the mud fluid was placed and the method or methods used in introducing it into the hold. If cement or other plugs were used, state the character of same and depth placed, from feet to feet for each plug set.

T.D. 3564'  
Set 1st plug at 550' with 50 sx.  
2nd plug at 240' with 25 sx.  
3rd plug at 40' with 10 sx.

RECEIVED  
STATE CORPORATION COMMISSION  
3/7/77  
MAR 07 1977

Cemented with 50/50 posmix, 2% gel.  
Plug was down at 1:30 a.m. 2-06-77.  
State Plugger - Leo Massey

CONSERVATION DIVISION  
Wichita, Kansas

(If additional description is necessary, use BACK of this sheet)

Name of Plugging Contractor Abercrombie Drilling, Inc.

STATE OF Kansas COUNTY OF Sedgwick ss.

Jack L. Partridge, Asst. Sec.-Treas. (employee of owner) or (owner or operator) of the above-described well, being first duly sworn on oath, says: That I have knowledge of the facts, statements, and matters herein contained and the log of the above-described well as filed and that the same are true and correct. So help me God.

(Signature) Jack L. Partridge  
801 Union Center, Wichita, Kansas 67202  
(Address)

Subscribed and Sworn to before me this 3rd day of March 1977

My commission expires

Kathy S. Goertz  
Kathy S. Goertz Notary Public.



CONTRACTOR'S WELL LOG

OPERATOR: Cities Service Oil Co.  
 CONTRACTOR: Abercrombie Drilling, Inc.  
 WELL NAME: RICHARDSON "A" #1  
 LOCATION: NW SW SW, Section 3-9S-18W  
 Rooks County, Kansas  
 SPUD DATE: 1-26-77  
 COMPLETION DATE: 2-06-77

0	210	Clay & Sand
210	281	Shale
281	1362	Shale & Sand
1362	1399	Anhydrite
1399	1429	Shale
1429	2482	Shale & Lime
2482	2450	Lime & Shale
2950	3475	Lime
3475	3564	Lime & Chert
	3564	Rotary Total Depth

Spud hole at 6:30 p.m. 1-26-77. Cut 281' of 12 1/4" hole. Ran 7 jts. of 8 5/8" Surface Casing. (Tally 273') Set at 280' with 175 sx. of Class "A" Cement, 2% Ca. Cl. Plug was down at 2:45 a.m. 1-27-77. Cement did circulate.

T.D. 3564', Set 1st plug at 550' with 50 sx., 2nd plug at 240' with 25 sx., 3rd plug at 40' with 10 sx., 50/50 posmix, 2% gel. Plug was down at 1:30 a.m. 2-06-77. State Plugger - Leo Massey.

SAMPLE TOPS:

Anhydrite 1361'  
 B/Anhydrite 1399'

RECEIVED  
 STATE OF KANSAS

MAR 07 1977

STATE OF KANSAS )  
 ) SS  
 COUNTY OF SEDGWICK )

CONSERVATION DIVISION  
 Wichita, Kansas

Jack L. Partridge, Assistant Secretary-Treasurer of Abercrombie Drilling, Inc., does hereby state that the above and foregoing is a true and correct log of the RICHARDSON "A" #1, NW SW SW, Section 3-9S-18W, Rooks County, Kansas.

Abercrombie Drilling, Inc.

BY: Jack L. Partridge  
 Jack L. Partridge, Asst. Sec.-Treas.

Subscribed and sworn to before me, a Notary Public, in and for the aforesaid county and state as of this 3rd day of March, 1977.

Kathy S. Goertz  
 Kathy S. Goertz, Notary Public

