

CARD MUST BE TYPED

State of Kansas

CARD MUST BE SIGNED

NOTICE OF INTENTION TO DRILL

(see rules on reverse side)

Starting Date 9 25 1987
month day year

API Number 15— 107-22,912-06-00

OPERATOR: License # 3523

NE NE SW Sec. 18 Twp. 22 S, Rg. 22 East
..... 2310 West

Name KERR MANAGEMENT COMPANY

..... 2970 Ft. from South Line of Section

Address 9701 E. Arapahoe Road

..... 2970 Ft. from East Line of Section

City/State/Zip Englewood, Colorado 80112

(Note: Locate well on Section Plat on reverse side)

Contact Person Bob Sadler

Nearest lease or unit boundary line 660 feet

Phone (913) 756-2223

County LINN

CONTRACTOR: License # 6451

Lease Name COX Well # I-1

Name Big "E" Drilling

Ground surface elevation feet MSL

City/State Centerville, Kansas 66014

Domestic well within 330 feet: yes no

Well Drilled For: Well Class: Type Equipment:

Municipal well within one mile: yes no

— Oil — SWD Infield — Mud Rotary

Depth to bottom of fresh water 20

— Gas Inj — Pool Ext. Air Rotary

Depth to bottom of usable water 150

— OWWO — Expl — Wildcat — Cable

Surface pipe by Alternate: 1 — 2

If OWWO: old well info as follows:

Surface pipe planned to be set 20

Operator

Conductor pipe required None

Well Name

Projected Total Depth 900 feet

Comp Date Old Total Depth

Formation Bartlesville

I certify that well will comply with K.S.A. 55-101, et seq., plus eventually plugging hole to KCC specifications.

Date ... 9-25-87 Signature of Operator or Agent

Frank Sandberg Title Agent

For KCC Use:

Conductor Pipe Required feet; Minimum Surface Pipe Required 20 feet per Alt. Y (2)


This Authorization Expires 3-25-88 9-30-89 Approved By P.H. 9-25-87

Must be filed with the K.C.C. five (5) days prior to commencing well
 This card void if drilling not started within six (6) months of date received by K.C.C.

Important procedures to follow:

1. Notify District office before setting surface casing.
2. Set surface casing by circulating cement to the top.
3. File completion forms ACO-1 with K.C.C. within 90 days of well completion, following instructions on ACO-1, side 1, and including copies of wireline logs.
4. Notify District office 48 hours prior to old well workover or re-entry.
5. Prior to filing Intent, prepare a proposed plugging plan in case well is D & A, then obtain approval of plan when calling district office prior to setting surface pipe.
6. Submit plugging report (CP-4) to K.C.C. after plugging is completed.
7. Obtain an approved injection docket number before disposing of salt water.
8. Notify K.C.C. within 10 days when injection commences or terminates.

A Regular Section of Land
 1 Mile = 5,280 Ft.

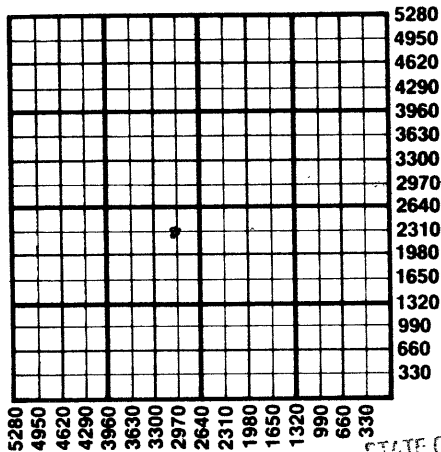

RECEIVED
 STATE CORPORATION COMMISSION

SEP 25 1987

CONSERVATION DIVISION
 Wichita, Kansas

alternate 2 completion, cement in the production pipe from
 below any usable water to surface within 120 days of spud date.

State Corporation Commission of Kansas
 Conservation Division
 200 Colorado Derby Building
 Wichita, Kansas 67202
 (316) 263-3238

9-25-87