CARD MUST BE TYPED

State of Kansas

NOTICE OF INTENTION TO DRILL

(see rules on reverse side)

CARD MUST BE SIGNED

Expected Spud Date: 2 (month) 10 (day) 1988 (year)

API Number 15— 107-22,956-00-00

OPERATOR: License # 3523

Name: KERR MANAGEMENT

Address: 9701 E. Arapahoe Road

City/State/Zip: Englewood, Colo. 80112

Contact Person: Bob Sadler

Phone: (913) 756-2223

CONTRACTOR: License # 6451

Name: Big"E" Drilling

City/State: Centerville, Kans. 66014

NW NW SW Sec. 18 Twp. 22 S, Rg. 22 X East ___ West

2145 Ft. from South Line of Section

3465 Ft. from East Line of Section

(Note: Locate well on Section Plat on reverse side)

Nearest lease or unit boundary line: 495 feet

County: LINN

Lease Name: COX Well #: 18

Ground surface elevation: ____ feet MSL

Domestic well within 330 feet: ___ yes X no

Municipal well within one mile: ___ yes X no

Depth to bottom of fresh water: 20

Depth to bottom of usable water: 150

Surface pipe by Alternate: 1 ___ 2 X

Surface pipe planned to be set: 20

Conductor pipe required: None

Projected Total Depth: 900 feet

Formation: Bartlesville

Well Drilled For:		Well Class:	Type Equipment:
X Oil	___ Storage	___ Infield	___ Mud Rotary
___ Gas	___ Inj	X Pool Ext.	X Air Rotary
___ OWWO	___ Expl	___ Wildcat	___ Cable

If OWWO: old well info as follows:

Operator: ____

Well Name: ____

Comp Date: ____ Old Total Depth: ____

I certify that well will comply with K.S.A. 55-101, et seq., plus eventually plugging hole to KCC specifications.

Date: 2-5-88 Signature of Operator or Agent: [signature] Title: Agent

For KCC Use:

Conductor Pipe Required ____ feet; Minimum Surface Pipe Required 20 feet per Alt. X (2)

This Authorization Expires: 8-5-88 Approved By: 2-5-88

EFFECTIVE DATE: 2-10-88

Must be filed with the K.C.C. five (5) days prior to commencing well
This card void if drilling not started within six (6) months of date received by K.C.C.

A Regular Section of Land
1 Mile = 5,280 Ft.

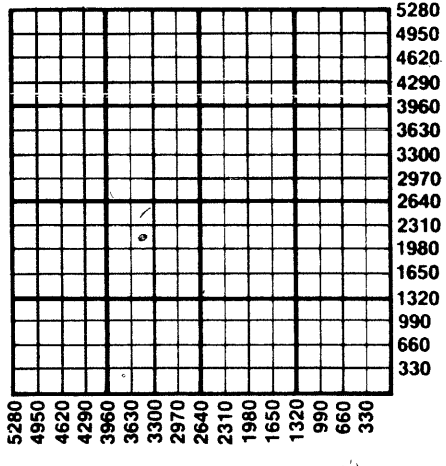

2-5-88

FEB 5 1988

CONSERVATION DIVISION
Wichita, Kansas

Important procedures to follow:

1. Notify District office before setting surface casing.
2. Set surface casing by circulating cement to the top.
3. File completion forms ACO-1 with K.C.C. within 120 days of well spud date, following instructions on ACO-1, side 1, and including copies of wireline logs.
4. Notify District office 48 hours prior to old well workover or re-entry.
5. Prior to filing Intent, prepare a proposed plugging plan in case well is D & A, then obtain approval of plan when calling district office prior to setting surface pipe.
6. Submit plugging report (CP-4) to K.C.C. after plugging is completed.
7. Obtain an approved injection docket number before disposing of salt water.
8. Notify K.C.C. within 10 days when injection commences or terminates.
9. If an alternate 2 completion, cement in the production pipe from below any usable water to surface within 120 days of spud date.

State Corporation Commission of Kansas
Conservation Division
200 Colorado Derby Building
Wichita, Kansas 67202-1212
(316) 263-3238