

CARD MUST BE TYPED

State of Kansas

CARD MUST BE SIGNED

NOTICE OF INTENTION TO DRILL

(see rules on reverse side)

Expected Spud Date..... 2 10 1988
month day year

API Number 15— 107-22,957-0060

OPERATOR: License # 3523
Name KERR MANAGEMENT
Address 9701 E. Arapahoe Road
City/State/Zip Englewood, Colo. 80112
Contact Person Bob Sadler
Phone (913) 756-2223

NW NE SW Sec... 18 Twp.. 22 S, Rg.. 22... East
2475 Ft. from South Line of Section
3750 Ft. from East Line of Section

(Note: Locate well on Section Plat on reverse side)

CONTRACTOR: License # 6451
Name Big "E" Drilling
City/State..... Centerville, Kansas 66014

Nearest lease or unit boundary line 165 feet
County... LINN
Lease Name..... COX Well # 19

Well Drilled For: Well Class: Type Equipment:
 Oil _____ Storage _____ Infield _____ Mud Rotary
_____ Gas _____ Inj _____ Pool Ext. _____ Air Rotary
_____ OWWO _____ Expl _____ Wildcat _____ Cable

Ground surface elevation feet MSL
Domestic well within 330 feet: _____ yes no
Municipal well within one mile: _____ yes no
Depth to bottom of fresh water 20
Depth to bottom of usable water 150
Surface pipe by Alternate: 1 _____ 2

If OWWO: old well info as follows:
Operator
Well Name
Comp Date..... Old Total Depth.....

Surface pipe planned to be set 20
Conductor pipe required None
Projected Total Depth 900 feet
Formation Bartlesville

I certify that well will comply with K.S.A. 55-101, et seq., plus eventually plugging hole to KCC specifications.

Date 2-5-88 Signature of Operator or Agent *Frank Crawford* Title..... Agent.....

For KCC Use:
Conductor Pipe Required feet; Minimum Surface Pipe Required 20 feet per Alt. (2)
This Authorization Expires *8-5-88* Approved By *Per 2-5-88*


EFFECTIVE DATE: 2-10-88

Must be filed with the K.C.C. five (5) days prior to commencing well
This card void if drilling not started within six (6) months of date received by K.C.C.

Important procedures to follow:

1. Notify District office before setting surface casing.
2. Set surface casing by circulating cement to the top.
3. File completion forms ACO-1 with K.C.C. within 120 days of well spud date, following instructions on ACO-1, side 1, and including copies of wireline logs.
4. Notify District office 48 hours prior to old well workover or re-entry.
5. Prior to filing Intent, prepare a proposed plugging plan in case well is D & A, then obtain approval of plan when calling district office prior to setting surface pipe.
6. Submit plugging report (CP-4) to K.C.C. after plugging is completed.
7. Obtain an approved injection docket number before disposing of salt water.
8. Notify K.C.C. within 10 days when injection commences or terminates.
9. If an alternate 2 completion, cement in the production pipe from below any usable water to surface within 120 days of spud date.

**A Regular Section of Land
1 Mile = 5,280 Ft.**

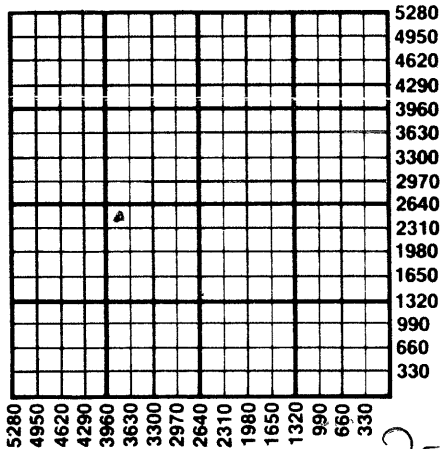

2-5-88
FEB 5 1988

CONSERVATION DIVISION
Wichita, Kansas

State Corporation Commission of Kansas
Conservation Division
200 Colorado Derby Building
Wichita, Kansas 67202-1212
(316) 263-3238