

CARD MUST BE TYPED

State of Kansas

CARD MUST BE SIGNED

### NOTICE OF INTENTION TO DRILL

(see rules on reverse side)

Expected Spud Date..... 2 23 1988  
month day year

API Number 15-107-22,964-000000 <sup>✓</sup>10

OPERATOR: License # ..... 3523 .....  
Name ..... KERR MANAGEMENT .....  
Address ..... 9701 E. Arapahoe Road .....  
City/State/Zip ..... Englewood, Colo. 80112 .....  
Contact Person ..... Bob Sadler .....  
Phone ..... (913) 756-2223 .....

NE. NW. SW. Sec. 18. Twp. 22 S, Rg. 22. <sup>X</sup> East  
2145 ..... Ft. from South Line of Section  
4095 ..... Ft. from East Line of Section

(Note: Locate well on Section Plat on reverse side)

CONTRACTOR: License # ..... 6451 .....  
Name ..... Big "E" Drilling .....  
City/State ..... Centerville, Kans. 66014 .....

Nearest lease or unit boundary line ..... 495 ..... feet  
County ..... LINN .....  
Lease Name ..... COX ..... Well # 22 .....

Well Drilled For: Well Class: Type Equipment:  
 Oil    \_\_\_ Storage    \_\_\_ Infield    \_\_\_ Mud Rotary  
\_\_\_ Gas    \_\_\_ Inj     Pool Ext.     Air Rotary  
\_\_\_ OWWO    \_\_\_ Expl    \_\_\_ Wildcat    \_\_\_ Cable

Ground surface elevation ..... feet MSL  
Domestic well within 330 feet:    \_\_\_ yes     no  
Municipal well within one mile:    \_\_\_ yes     no  
Depth to bottom of fresh water ..... 20 .....  
Depth to bottom of usable water ..... 150 .....

If OWWO: old well info as follows:

Operator .....  
Well Name .....  
Comp Date ..... Old Total Depth.....

Surface pipe by Alternate:    1 \_\_\_ 2   
Surface pipe planned to be set ..... 20 .....  
Conductor pipe required ..... None .....  
Projected Total Depth ..... 900 ..... feet  
Formation ..... Bartlesville .....

I certify that well will comply with K.S.A. 55-101, et seq., plus eventually plugging hole to KCC specifications.

Date ..... 2-18-88 ..... Signature of Operator or Agent *Frank Braden* ..... Title ..... Agent .....

For KCC Use:

Conductor Pipe Required ..... feet; Minimum Surface Pipe Required ..... 20 ..... feet per Alt. **X (2)**  
This Authorization Expires 8-18-88 ..... Approved By PH 2-18-88 .....


EFFECTIVE DATE: 2-23-88

Must be filed with the K.C.C. five (5) days prior to commencing well  
This card void if drilling not started within six (6) months of date received by K.C.C.

### Important procedures to follow:

1. Notify District office before setting surface casing.
2. Set surface casing by circulating cement to the top.
3. File completion forms ACO-1 with K.C.C. within 120 days of well spud date, following instructions on ACO-1, side 1, and including copies of wireline logs.
4. Notify District office 48 hours prior to old well workover or re-entry.
5. Prior to filing Intent, prepare a proposed plugging plan in case well is D & A, then obtain approval of plan when calling district office prior to setting surface pipe.
6. Submit plugging report (CP-4) to K.C.C. after plugging is completed.
7. Obtain an approved injection docket number before disposing of salt water.
8. Notify K.C.C. within 10 days when injection commences or terminates.

**A Regular Section of Land**  
**1 Mile = 5,280 Ft.**

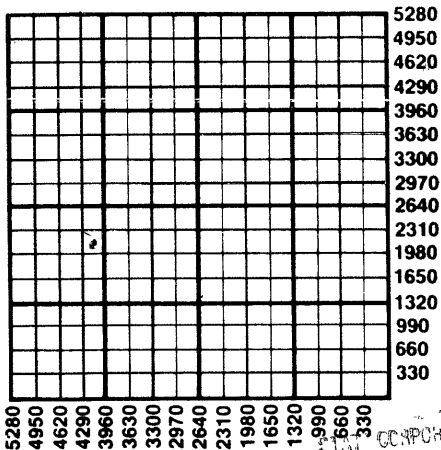

STATE CORPORATION COMMISSION

FEB 18 1988

CONSERVATION DIVISION  
Wichita, Kansas

*2-18-88*

If an alternate 2 completion, cement in the production pipe from below any usable water to surface within 120 days of spud date.

State Corporation Commission of Kansas  
Conservation Division  
200 Colorado Derby Building  
Wichita, Kansas 67202-1212  
(316) 263-3238