

CARD MUST BE TYPED

State of Kansas

CARD MUST BE SIGNED

NOTICE OF INTENTION TO DRILL

(see rules on reverse side)

Expected Spud Date..... 5 9 1988
month day year

OPERATOR: License # 3523
Name KERR MANAGEMENT
Address 9701 E. Arapahoe Road
City/State/Zip Englewood, Colo. 80112
Contact Person..... Bob Sadler
Phone..... (913) 756-2223

CONTRACTOR: License # 6451
Name Big "E" Drilling
City/State..... Centerville, Kansas 66014

Well Drilled For: Well Class: Type Equipment:
___ Oil ___ Storage Infield ___ Mud Rotary
___ Gas WSW ___ Pool Ext. Air Rotary
___ OWWO ___ Expl ___ Wildcat ___ Cable

IF OWWO: old well info as follows:
Operator
Well Name
Comp Date..... Old Total Depth.....

I certify that well will comply with K.S.A. 55-101, et seq., plus eventually plugging hole to KCC specifications.
Date 5-4-88 Signature of Operator or Agent *Frank Bradford* Title..... Agent

For KCC Use:
Conductor Pipe Required feet; Minimum Surface Pipe Required 20 feet per Alt. X (2)
This Authorization Expires *11-4-88*

EFFECTIVE DATE: *5-9-88*

API Number 15—*107-22,997-00-00*

SE SW SW Sec. 18 Twp. 22 S, Rg. 22 East
330 _____ Ft. from South Line of Section
4220 _____ Ft. from East Line of Section

(Note: Locate well on Section Plat on reverse side)

Nearest lease or unit boundary line 330 feet
County..... LINN

Lease Name..... COX Well # 1-WSW

Ground surface elevation feet MSL
Domestic well within 330 feet: ___yes no

Municipal well within one mile: ___yes no

Depth to bottom of fresh water..... 20

Depth to bottom of usable water 150

Surface pipe by Alternate: 1 ___ 2

Surface pipe planned to be set 20

Conductor pipe required None

Projected Total Depth 990 feet

Formation..... Mississippi


Approved By *PCB 5-4-88*

Must be filed with the K.C.C. five (5) days prior to commencing well
 This card void if drilling not started within six (6) months of date received by K.C.C.

Important procedures to follow:

1. Notify District office before setting surface casing.
2. Set surface casing by circulating cement to the top.
3. File completion forms ACO-1 with K.C.C. within 120 days of well spud date, following instructions on ACO-1, side 1, and including copies of wireline logs.
4. Notify District office 48 hours prior to old well workover or re-entry.
5. Prior to filing Intent, prepare a proposed plugging plan in case well is D & A, then obtain approval of plan when calling district office prior to setting surface pipe.
6. Submit plugging report (CP-4) to K.C.C. after plugging is completed.
7. Obtain an approved injection docket number before disposing of salt water.

A Regular Section of Land
 1 Mile = 5,280 Ft.

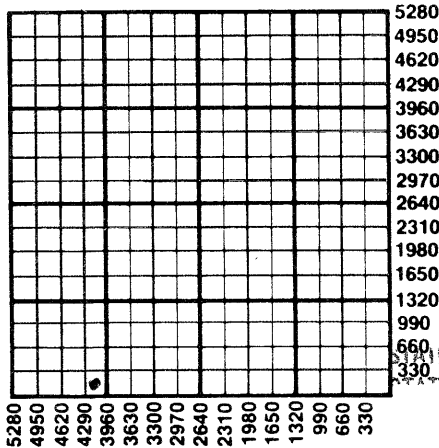

RECEIVED
 STATE CORPORATION COMMISSION
 WICHITA, KANSAS

MAY 04 1988

CONSERVATION DIVISION
 Wichita, Kansas

g-4-88

File completion forms ACO-1 with K.C.C. within 10 days when injection commences or terminates.
 an alternate 2 completion, cement in the production pipe from below any usable water to surface within 120 days of spud date.

State Corporation Commission of Kansas
 Conservation Division
 200 Colorado Derby Building
 Wichita, Kansas 67202-1212
 (316) 263-3238