

CARD MUST BE TYPED

State of Kansas  
**NOTICE OF INTENTION TO DRILL**  
(see rules on reverse side)

CARD MUST BE SIGNED

Starting Date: 4 11 1985  
month day year

API Number 15-107-22,532-00-00

OPERATOR: License # 5756  
Name Triple-I Energy Corp.  
Address 6600 College Blvd., #310  
City/State/Zip Overland Park, Ks 66211  
Contact Person Debbie Ballard  
Phone 913 345 8000

SW SE SW 35 22 21  East  
..... Sec ..... Twp ..... S, Rge .....  West  
(location)  
220  
..... Ft North from Southeast Corner of Section  
..... 37.40..... Ft West from Southeast Corner of Section  
(Note: Locate well on Section Plat on reverse side)

CONTRACTOR: License # 5675  
Name McPherson Drilling Co.  
City/State Box 308, Cherryvale, Ks 67333

Nearest lease or unit boundary line 220 feet.  
County Linn  
Lease Name Holmes Well# B-4

Well Drilled For: Well Class: Type Equipment:  
 Oil  Swd  Infield  Mud Rotary  
 Gas  Inj  Pool Ext.  Air Rotary  
 OWWO  Expl  Wildcat  Cable

Domestic well within 330 feet:  yes  no  
Municipal well within one mile:  yes  no

If OWWO: old well info as follows:  
Operator .....  
Well Name .....  
Comp Date ..... Old Total Depth .....  
Projected Total Depth 900 feet  
Projected Formation at TD .....  
Expected Producing Formations .....

Depth to Bottom of fresh water ..... 75..... feet  
Lowest usable water formation ..... Dennis Limestone...  
Depth to Bottom of usable water ..... 150..... feet  
Surface pipe by Alternate: 1  2   
Surface pipe to be set ..... 20..... feet  
Conductor pipe if any required ..... feet  
Ground surface elevation ..... feet MSL  
This Authorization Expires 10-11-85  
Approved By RCH/KCC 4-11-85

I certify that we will comply with K.S.A. 55-101, et seq., plus eventually plugging hole to K.C.C. specifications.

Date 4/11/85 Signature of Operator or Agent

*Elmer Dorman* Title as agent

W.H.C. / K.C.C. 4-11-85 Form C-1 4/84


Must be filed with the K.C.C. five (5) days prior to commencing well  
 and void if drilling not started within six (6) months of date received by K.C.C.  
 CONSERVATION DIVISION  
 STATE CORPORATION COMMISSION, KANSAS

4-11-85

APR 11 1985

**Important procedures to follow :**

A Regular Section and  
 STATE CORPORATION COMMISSION  
 REG. DIST. 9  
 1 Mile = 330

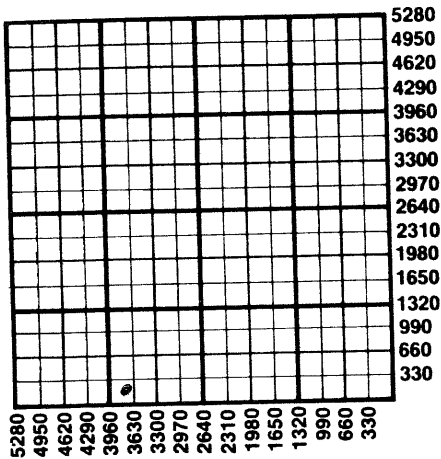

1. Notify District office before setting surface casing.
2. Set surface casing by circulating cement to the top.
3. File completion forms ACO-1 with K.C.C. within 90 days of well completion, following instructions on ACO-1, side 1, and including copies of wireline logs.
4. Notify District office 48 hours prior to old well workover or re-entry.
5. Prior to plugging, prepare a plugging plan, then obtain agreement from the appropriate district office for an approved plugging plan.
6. Submit plugging report (CP-4) to K.C.C. after plugging is completed.
7. Obtain an approved injection docket number before disposing of salt water.
8. Notify K.C.C. within 10 days when injection commences or terminates.
9. If an alternate 2 completion, cement in the production pipe from below any usable water to surface within 120 days of spud date.

State Corporation Commission of Kansas  
 Conservation Division  
 200 Colorado Derby Building  
 Wichita, Kansas 67202  
 (316) 263-3238