

CARD MUST BE TYPED

State of Kansas
NOTICE OF INTENTION TO DRILL

CARD MUST BE SIGNED ✓

(see rules on reverse side)

Starting Date 1-7-86
month day year

API Number 15- 107-22,780-00-00

OPERATOR: License # 6756
Name McGown Oil, Inc.
Address RR# 1 Box 28A
City/State/Zip Mound City, Kansas 66056
Contact Person Gilbert McGown
Phone 913-795-2258

NE NW SE. Sec. 1 Twp. 22 S, Rg. 22
2350 Ft. from South Line of Section
1650 Ft. from East Line of Section

(Note: Locate well on Section Plat on reverse side)

CONTRACTOR: License # 5786
Name McGown Drilling, Inc.
City/State Mound City, Kansas 66056

Nearest lease or unit boundary line 330 feet
County Linn

Lease Name McGown Well # G3-86
Ground surface elevation NA feet MSL

Well Drilled For: Well Class: Type Equipment:
Oil SWD Infield X Mud Rotary
X Gas Inj Pool Ext Air Rotary
OWWO Expl X Wildcat Cable

Domestic well within 330 feet: yes X no
Municipal well within one mile: yes X no

Surface pipe by Alternate: 1 2X
Depth to bottom of fresh water 85

If OWWO: old well info as follows:

Operator
Well Name
Comp Date Old Total Depth

Depth to bottom of usable water 150
Surface pipe planned to be set 150

Projected Total Depth 700 feet
Formation Bartelsville

I certify that well will comply with K.S.A. 55-101, et seq., plus eventually plugging hole to KCC specifications.

Date Signature of Operator or Agent [Signature] Title Agent

For KCC Use:
Conductor Pipe Required feet; Minimum Surface Pipe Required 20' feet per Alt.


This Authorization Expires 7-6-86 Approved By [Signature] 1-6-86

Must be filed with the K.C.C. five (5) days prior to commencing well
This card void if drilling not started within six (6) months of date received by K.C.C.

Important procedures to follow:

1. Notify District office before setting surface casing.
2. Set surface casing by circulating cement to the top.
3. File completion forms ACO-1 with K.C.C. within 90 days of well completion, following instructions on ACO-1, side 1, and including copies of wireline logs.
4. Notify District office 48 hours prior to old well workover or re-entry.
5. Prior to filing Intent, prepare a proposed plugging plan in case well is D & A, then obtain approval of plan when calling district office prior to setting surface pipe.
6. Submit plugging report (CP-4) to K.C.C. after plugging is completed.
7. Obtain an approved injection docket number before disposing of salt water.
8. Notify K.C.C. within 10 days when injection commences or terminates.
9. If an alternate 2 completion, cement in the production pipe from below any usable water to surface within 120 days of spud date.

**A Regular Section of Land
1 Mile = 5,280 Ft.**

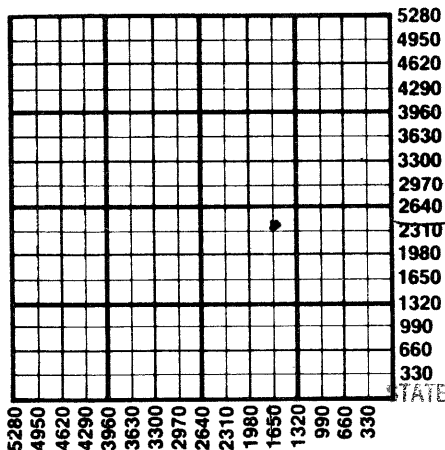

RECEIVED

STATE CORPORATION COMMISSION

JAN 6 1985

CONSERVATION DIVISION
Wichita, Kansas

1-6-86

State Corporation Commission of Kansas
Conservation Division
200 Colorado Derby Building
Wichita, Kansas 67202
(316) 263-3238