

CARD MUST BE TYPED

State of Kansas
NOTICE OF INTENTION TO DRILL
(see rules on reverse side)

CARD MUST BE SIGNED

Starting Date: February 1 1985
month day year

API Number 15- 107-22,503-00-00
SE NE NE NW Sec 2 Twp 22 S, Rge 22 East West
(location)

OPERATOR: License # 4007
Name Orion Energy of Kansas Inc.
Address 4849 Greenville Ave. Suite 790
City/State/Zip Dallas, Texas 75206
Contact Person Marla R. Burtcheard
Phone 214/361-8183

4785 Ft North from Southeast Corner of Section
2805 Ft West from Southeast Corner of Section
(Note: Locate well on Section Plat on reverse side)

CONTRACTOR: License # 5786
Name McGown Drilling, Inc.
City/State Mound City, Kansas

Nearest lease or unit boundary line 495 feet.
County Linn
Lease Name Lanham Well# 3

Domestic well within 330 feet: yes no
Municipal well within one mile: yes no

Well Drilled For: Well Class: Type Equipment:
 Oil Swd Infield Mud Rotary
 Gas Inj Pool Ext. Air Rotary
 OWWO Expl Wildcat Cable

Depth to Bottom of fresh water unknown feet

Lowest usable water formation

Depth to Bottom of usable water 150 feet

Surface pipe by Alternate: 1 2

Surface pipe to be set 40 feet

Conductor pipe if any required not required feet

Ground surface elevation approximately 989 feet MSL

This Authorization Expires 7-18-85

Approved By 1-18-85 *[Signature]*

I certify that we will comply with K.S.A. 55-101, et seq., plus eventually plugging hole to K.C.C. specifications.

Date 1-16-85 Signature of Operator or Agent


Maren R Burtcheard Title *Production Assistant*

MHC/WOHE 1-18-85
Form C-1 4/84

**Must be filed with the K.C.C. five (5) days prior to commencing well
This card void if drilling not started within six (6) months of date received by K.C.C.**

Important procedures to follow :

**A Regular Section of Land
1 Mile = 5,280 Ft.**

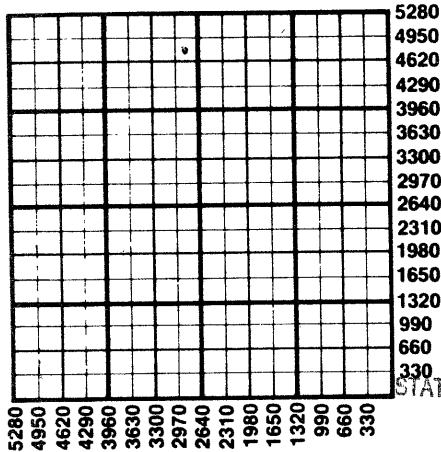

1. Notify District office before setting surface casing.
 2. Set surface casing by circulating cement to the top.
 3. File completion forms ACO-1 with K.C.C. within 90 days of well completion, following instructions on ACO-1, side 1, and including copies of wireline logs.
 4. Notify District office 48 hours prior to old well workover or re-entry.
 5. Prior to plugging, prepare a plugging plan, then obtain agreement from the appropriate district office for an approved plugging plan.
 6. Submit plugging report (CP-4) to K.C.C. after plugging is completed.
 7. Obtain an approved injection docket number before disposing of salt water.
 8. Notify K.C.C. within 10 days when injection commences or terminates.
9. If an alternate 2 completion, cement in the production pipe from below any usable water to surface within 120 days of spud date.

RECEIVED
STATE CORPORATION COMMISSION

JAN 18 1985

CONSERVATION DIVISION
Wichita, Kansas

**State Corporation Commission of Kansas
Conservation Division
200 Colorado Derby Building
Wichita, Kansas 67202
(316) 263-3238**

1-18-85