

CARD MUST BE TYPED

State of Kansas

CARD MUST BE SIGNED

### NOTICE OF INTENTION TO DRILL

(see rules on reverse side)

Expected Spud Date..... 6 26 87  
month day year

API Number 15— 107-22, 865-00-00

OPERATOR: License #..... 03093  
Name..... CHAZ Oil Corp.  
Address..... P.O. Box 281  
City/State/Zip..... Paola, KS 66071  
Contact Person..... Mark Swope  
Phone..... (913) 755-2128

X East  
S/2 NW SE. Sec. 18 Twp. 22 S, Rg. 22 West  
..... 1540 Ft. from South Line of Section  
..... 1980 Ft. from East Line of Section

(Note: Locate well on Section Plat on reverse side)

CONTRACTOR: License #..... 6142  
Name..... Town Oil Co.  
City/State..... Paola, KS 66071

Nearest lease or unit boundary line..... 660 feet  
County..... Linn  
Lease Name..... Wright Well #..... 8-87

Well Drilled For: Well Class: Type Equipment:  
X Oil      \_\_\_ Storage      X Infield      X Mud Rotary  
\_\_\_ Gas      \_\_\_ Inj      \_\_\_ Pool Ext.      \_\_\_ Air Rotary  
\_\_\_ OWWO      \_\_\_ Expl      \_\_\_ Wildcat      \_\_\_ Cable

Ground surface elevation..... feet MSL  
Domestic well within 330 feet:      \_\_\_ yes      X no  
Municipal well within one mile:      \_\_\_ yes      X no  
Depth to bottom of fresh water..... 20'  
Depth to bottom of usable water..... 150'  
Surface pipe by Alternate:      1 \_\_\_ 2 X  
Surface pipe planned to be set..... 20'  
Conductor pipe required.....  
Projected Total Depth..... 700 feet  
Formation..... Bartlesville

If OWWO: old well info as follows:  
Operator.....  
Well Name.....  
Comp Date..... Old Total Depth.....

I certify that well will comply with K.S.A. 55-101, et seq., plus eventually plugging hole to KCC specifications.  
Date..... 6/16/87 Signature of Operator or Agent..... Mark Swope Title..... Agent.....


For KCC Use:  
Conductor Pipe Required..... feet; Minimum Surface Pipe Required..... 20 feet per Alt. X  
This Authorization Expires..... 12-18-87 Approved By..... MS 6-18-87

Must be filed with the K.C.C. five (5) days prior to commencing well  
 This card void if drilling not started within six (6) months of date received by K.C.C.

**Important procedures to follow:**

1. Notify District office before setting surface casing.
2. Set surface casing by circulating cement to the top.
3. File completion forms ACO-1 with K.C.C. within 120 days of well spud date, following instructions on ACO-1, side 1, and including copies of wireline logs.
4. Notify District office 48 hours prior to old well workover or re-entry.
5. Prior to filing Intent, prepare a proposed plugging plan in case well is D & A, then obtain approval of plan when calling district office prior to setting surface pipe.
6. Submit plugging report (CP-4) to K.C.C. after plugging is completed.
7. Obtain an approved injection docket number before disposing of salt water.

**A Regular Section of Land**  
**1 Mile = 5,280 Ft.**

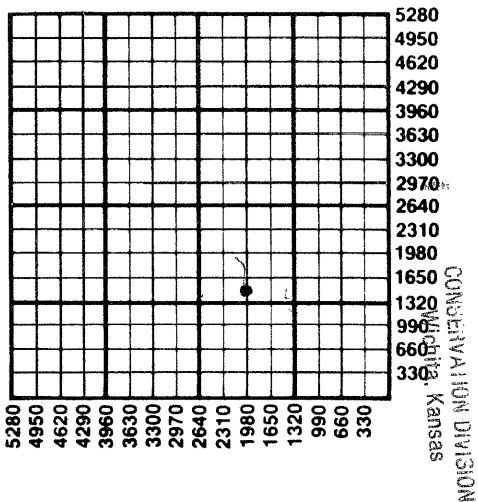

JUN 18 1987

RECEIVED  
 STATE CORPORATION COMMISSION

Notify K.C.C. within 10 days when injection commences or terminates.  
 an alternate 2 completion, cement in the production pipe from below any usable water to surface within 120 days of spud date.

6-18-87

State Corporation Commission of Kansas  
 Conservation Division  
 200 Colorado Derby Building  
 Wichita, Kansas 67202-1212  
 (316) 263-3238