

CARD MUST BE TYPED

State of Kansas

CARD MUST BE SIGNED

NOTICE OF INTENTION TO DRILL

(see rules on reverse side)

COLLECTED  
1-15-86

Starting Date January 7, 1986  
month day year

API Number 15— 163-22, 857-00-00  
Approx.

OPERATOR: License # 5134  
Name Graham-Michaelis Corporation  
Address P. O. Box 247  
City/State/Zip Wichita, Kansas 67201  
Contact Person Jack L. Yinger  
Phone (316) 264-8394

NE.. SE.. NW Sec. 26 Twp. 8S S, Rg. 17W X West  
3530  
\* 29670 Ft. from East Line of Section

(Note: Locate well on Section Plat on reverse side)

CONTRACTOR: License # Unknown 6427  
Name Rosencrantz & Bemis  
City/State Great Bend, Kansas

Nearest lease or unit boundary line 330 feet  
County Rooks  
Lease Name Hrabe 1-26 Well # 1-26 WSW  
Ground surface elevation app. 1989 feet MSL

Well Drilled For: Water Supply Well Class: Type Equipment:  
\_\_\_ Oil \_\_\_ SWD \_\_\_ Infield X Mud Rotary  
\_\_\_ Gas \_\_\_ Inj \_\_\_ Pool Ext. \_\_\_ Air Rotary  
\_\_\_ OWWO \_\_\_ Expl \_\_\_ Wildcat \_\_\_ Cable

Domestic well within 330 feet: \_\_\_ yes X no  
Municipal well within one mile: \_\_\_ yes X no  
Surface pipe by Alternate: 1 2 X  
Depth to bottom of fresh water 50  
Depth to bottom of usable water ~ 80  
Surface pipe planned to be set 90  
Projected Total Depth 1050 feet  
Formation Cedar Hills

If OWWO: old well info as follows:  
Operator  
Well Name  
Comp Date Old Total Depth

I certify that well will comply with K.S.A. 55-101, et seq., plus eventually plugging hole to KCC specifications. *was 306 OF PL*  
*Per KCC*  
cementing will be done immediately upon setting production casing. Jack L. Yinger  
Date Signature of Operator or Agent Title Vice President

For KCC Use:  
Conductor Pipe Required \_\_\_\_\_ feet; Minimum Surface Pipe Required \_\_\_\_\_ feet per ft. 1 2  
This Authorization Expires 7-3-86 Approved By 1-3-86


Must be filed with the K.C.C. five (5) days prior to commencing well  
This card void if drilling not started within six (6) months of date received by K.C.C.

### Important procedures to follow:

1. Notify District office before setting surface casing.
2. Set surface casing by circulating cement to the top.
3. File completion forms ACO-1 with K.C.C. within 90 days of well completion, following instructions on ACO-1, side 1, and including copies of wireline logs.
4. Notify District office 48 hours prior to old well workover or re-entry.
5. Prior to filing Intent, prepare a proposed plugging plan in case well is D & A, then obtain approval of plan when calling district office prior to setting surface pipe.
6. Submit plugging report (CP-4) to K.C.C. after plugging is completed.
7. Obtain an approved injection docket number before disposing of salt water.
8. Notify K.C.C. within 10 days when injection commences or terminates.
9. If an alternate 2 completion, cement in the production pipe from below any usable water to surface within 120 days of spud date.

### A Regular Section of Land

1 Mile = 5,280 Ft.

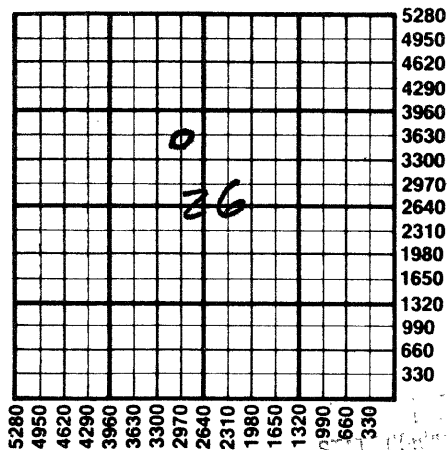

DEC 23 1985  
W-23-85  
CONSERVATION DIVISION

State Corporation Commission of Kansas  
Conservation Division  
200 Colorado Derby Building  
Wichita, Kansas 67202  
(316) 263-3238