


15-163-00936-00-00

STATE OF KANSAS
STATE CORPORATION COMMISSION

Give All Information Completely
Make Required Affidavit
Mail or Deliver Report to:
Conservation Division
State Corporation Commission
211 No. Broadway
Wichita, Kansas

WELL PLUGGING RECORD

NORTH

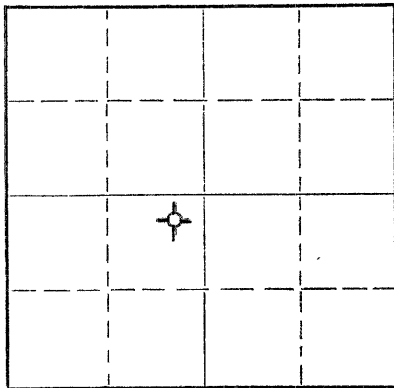

Locate well correctly on above
Section Plat

Rooks County, Sec. 26 Twp. 8 Rge. 17W(E) (W)
Location as "NE/CNW/SW" or footage from lines NE NE SW
Lease Owner C-G Drilling Co. & Holly Oil Company
Lease Name Hrabe "A" Well No. 1
Office Address 107 Rule Building, Wichita 2, Kansas
Character of Well (completed as Oil, Gas or Dry Hole) Dry Hole
Date well completed September 21 19 59
Application for plugging filed September 21 19 59
Application for plugging approved September 21 19 59
Plugging commenced September 21 19 59
Plugging completed September 21 19 59
Reason for abandonment of well or producing formation Too low structurally

If a producing well is abandoned, date of last production 19
Was permission obtained from the Conservation Division or its agents before plugging was commenced? Yes

Name of Conservation Agent who supervised plugging of this well Eldon Petty, Hays, Kansas
Producing formation _____ Depth to top _____ Bottom _____ Total Depth of Well 3474 Feet
Show depth and thickness of all water, oil and gas formations.

OIL, GAS OR WATER RECORDS

CASING RECORD

FORMATION	CONTENT	FROM	TO	SIZE	PUT IN	PULLED OUT
				8-5/8"	166.46'	None

Describe in detail the manner in which the well was plugged, indicating where the mud fluid was placed and the method or methods used in introducing it into the hole. If cement or other plugs were used, state the character of same and depth placed, from _____ feet to _____ feet for each plug set.

Filled hole with heavy mud to 660'. Set plug. Put in 20 sacks cement. Filled to 160'. Set plug. Put in 1/2 sack hulls and 15 sacks cement. Filled with heavy mud up to 40'. Set plug. Filled to top with 1/2 sack hulls and 10 sacks cement.

RECEIVED
STATE CORPORATION COMMISSION

SEP 28 1959

CONSERVATION DIVISION
Wichita, Kansas

(If additional description is necessary, use BACK of this sheet)
Name of Plugging Contractor C-G Drilling Co. 9-28-59
Address 107 Rule Building, Wichita 2, Kansas

STATE OF KANSAS, COUNTY OF SEDGWICK, ss.
G. F. Galloway (employee of owner) or (owner or operator) of the above-described well, being first duly sworn on oath, says: That I have knowledge of the facts, statements, and matters herein contained and the log of the above-described well as filed and that the same are true and correct. So help me God.

(Signature) G. F. Galloway
107 Rule Building
(Address)

SUBSCRIBED AND SWORN TO before me this 24th day of September, 1959

My commission expires May 20, 1963

Vicky Jacobs
Notary Public.

PLUGGING

File Sec. 26 - 8 - 17W

Book Page 4 Line 40

15-163-00936-00-00

WELL LOG

OPERATOR C-G Drilling Co. & Holly Oil Company SEC. 26-8-17W
 WELL NAME Hrabe "A" #1 LOC. NE NE SW
 TOTAL DEPTH 3474' COUNTY Rooks
 COMM. 9/14/59 COMP. 9/21/59 STATE Kansas
 RIG NO. 1 ELEVATION 1992' R.B.

CASING: Ran 166.46' (8 jts.) 8-5/8" OD Surface Casing. PRODUCTION: D & A

All measurements taken from the top of rotary bushing.

FROM	TO	FORMATION	DEVIATION FROM VERTICAL	REMARKS:
0	350	Shale		
350	560	Shale-Shell Streaks		
560	620	Sand		
620	1005	Shale-Sand		
1005	1294	Red Bed-Shale		
1294	1330	Anhydrite		
1330	1755	Shale		
1755	1935	Shale-Lime	0° - 2500	
1935	2960	Lime-Shale	0° - 2750	
2960	3055	Shale-Lime	0° - 3000	
3055	3175	Lime-Shale		
3175	3242	Lime		
3242	3315	Lime-Shale	0° - 3250	DST 3221-3242'
3315	3368	Lime		
3368	3474	Lime-Shale		

RECEIVED
 STATE CORPORATION COMMISSION

SEP 28 1959

CONSERVATION DIVISION
 Wichita, Kansas

9-28-59

STATE OF KANSAS }
 COUNTY OF SEDGWICK } SS.

The undersigned hereby certifies that to the best of his knowledge and belief, the above facts are true and correct.

C-G DRILLING CO.

By G. F. Galloway
 G. F. Galloway

SUBSCRIBED AND SWORN TO, BEFORE ME, THIS 24th day of September, 1959.

My commission expires:
 May 20, 1963

Vicky Jacobs
 Vicky Jacobs - Notary public

PLUGGING

File Sec. 26 T 8 R 174

Book Page 4 Line 40