

15-163-20237-00-00

STATE OF KANSAS
STATE CORPORATION COMMISSION


Form CP-4

WELL PLUGGING RECORD

Give All Information Completely
Make Required Affidavit
Mail or Deliver Report to:
Conservation Division
State Corporation Commission
212 No. Market
Wichita, Kansas

Rooks County, Sec. 26 Twp. 8S Rge. (E) 17 (W)

Location as "NE/CNW/SW" or footage from lines NW NW SE
Lease Owner A. Scott Ritchie
Lease Name Erabe Well No. 1
Office Address 412 Union Center - Wichita, Kansas
Character of Well (completed as Oil, Gas or Dry Hole) dry
Date well completed 8-5- 19 69
Application for plugging filed 8-5 19 69
Application for plugging approved 8-5 19 69
Plugging commenced 8:15 AM 8-5 19 69
Plugging completed 9:30 AM 8-5 19 69
Reason for abandonment of well or producing formation dry

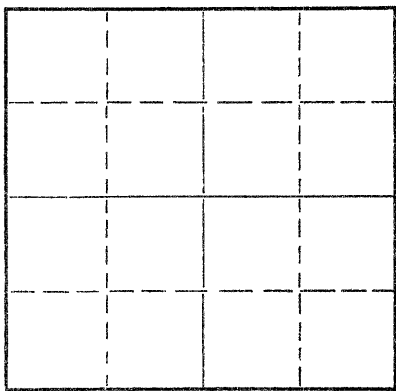

Locate well correctly on above
Section Plat

If a producing well is abandoned, date of last production _____ 19 ____
Was permission obtained from the Conservation Division or its agents before plugging was commenced? yes

Name of Conservation Agent who supervised plugging of this well Leo Massey
Producing formation _____ Depth to top _____ Bottom _____ Total Depth of Well 3473' Feet
Show depth and thickness of all water, oil and gas formations.

OIL, GAS OR WATER RECORDS

CASING RECORD

FORMATION	CONTENT	FROM	TO	SIZE	PUT IN	PULLED OUT
Shale		0	201	8 5/8"	201	0

Describe in detail the manner in which the well was plugged, indicating where the mud fluid was placed and the method or methods used in introducing it into the hole. If cement or other plugs were used, state the character of same and depth placed, from _____ feet to _____ feet for each plug set.

Plug hole - 600' with 70 sx 180' with 20 sx
40' with 16 sx 2 sx in rat hole
by Leo Massey and Globe

RECEIVED
STATE CORPORATION COMMISSION
AUG 7 1969
CONSERVATION DIVISION
Wichita, Kansas

(If additional description is necessary, use BACK of this sheet)
Name of Plugging Contractor B & B DRILLING, INC.
Address 207 Petroleum Building - Wichita, Kansas

8-7-69

STATE OF Kansas, COUNTY OF Sedgwick, ss.
Bill Lahar (employee of owner) or (owner or operator) of the above-described well, being first duly sworn on oath, says: That I have knowledge of the facts, statements, and matters herein contained and the log of the above-described well as filed and that the same are true and correct. So help me God.

(Signature) Bill Lahar
207 Petroleum Building - Wichita, Kansas
(Address)

SUBSCRIBED AND SWORN TO before me this 6th day of August, 19 69

My commission expires May 31, 1970

Alma A. Neuse
Notary Public.