

CARD MUST BE TYPED

State of Kansas

CARD MUST BE SIGNED

NOTICE OF INTENTION TO DRILL

(see rules on reverse side)

Expected Spud Date..... June 8, 1987
month day year 11/32

API Number 15— 107-22,862-00-00

OPERATOR: License # 5115
Name Reese Exploration, Inc.
Address 5540 Raytown Road
City/State/Zip Raytown, MO 64133
Contact Person Pattie
Phone (816) 356-1970

SE NW NW
4510 Sec. 30 Twp. 22 S, Rg. 22 X East
4235 Ft. from South Line of Section
Ft. from East Line of Section

(Note: Locate well on Section Plat on reverse side)

CONTRACTOR: License # 6451
Name Big E Drilling
City/State Route 1, Centerville, Kansas 66014

Nearest lease or unit boundary line 700 feet
County Linn
Lease Name Jones Well # 2-87

Well Drilled For: Well Class: Type Equipment:
X Oil — Storage — Infield X Mud Rotary
— Gas — Inj X Pool Ext. — Air Rotary
— OWWO — Expl — Wildcat — Cable

Ground surface elevation _____ feet MSL
Domestic well within 330 feet: — yes X no
Municipal well within one mile: — yes X no
Depth to bottom of fresh water 20
Depth to bottom of usable water 150
Surface pipe by Alternate: 1 2 X
Surface pipe planned to be set 20

If OWWO: old well info as follows:
Operator _____
Well Name _____
Comp Date _____ Old Total Depth _____

Conductor pipe required _____
Projected Total Depth 820 feet
Formation Bartlesville

I certify that well will comply with K.S.A. 55-101, et seq., plus eventually plugging hole to KCC specifications.
Date 6/8/87 Signature of Operator or Agent Walter Jones Title As Agent

For KCC Use:
Conductor Pipe Required _____ feet; Minimum Surface Pipe Required 20 feet per Alt. 20
This Authorization Expires 12-8-87 Approved By 6-8-87


[Handwritten signature]

Must be filed with the K.C.C. five (5) days prior to commencing well
 This card void if drilling not started within six (6) months of date received by K.C.C.

Important procedures to follow:

1. Notify District office before setting surface casing.
2. Set surface casing by circulating cement to the top.
3. File completion forms ACO-1 with K.C.C. within 120 days of well spud date, following instructions on ACO-1, side 1, and including copies of wireline logs.
4. Notify District office 48 hours prior to old well workover or re-entry.
5. Prior to filing Intent, prepare a proposed plugging plan in case well is D & A, then obtain approval of plan when calling district office prior to setting surface pipe.
6. Submit plugging report (CP-4) to K.C.C. after plugging is completed.
7. Obtain an approved injection docket number before disposing of salt water.
8. Notify K.C.C. within 10 days when injection commences or terminates.
9. If an alternate 2 completion, cement in the production pipe from how any usable water to surface within 120 days of spud date.

A Regular Section of Land
1 Mile = 5,280 Ft.

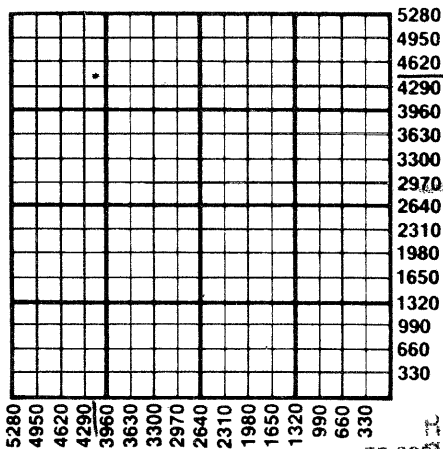

6-8-87

RECEIVED

JUN 9 1987

CONSERVATION DIVISION
 Wichita, Kansas

State Corporation Commission of Kansas
 Conservation Division
 200 Colorado Derby Building
 Wichita, Kansas 67202-1212
 (316) 263-3238