

CARD MUST BE TYPED

State of Kansas

CARD MUST BE SIGNED

NOTICE OF INTENTION TO DRILL

(see rules on reverse side)

Expected Spud Date. JUNE 30, 1987
month day year
#5115

API Number 15— 107-22,871-00-00

OPERATOR: License #
Name REESE EXPLORATION, INC.
Address 5540 RAYTOWN ROAD
City/State/Zip RAYTOWN, MO 64133
Contact Person PATTIE
Phone (816) 356-1970

NW NE SE
Sec 30 Twp 22 S, Rg 22 X East
2240 Ft. from South Line of Section
900 Ft. from East Line of Section

(Note: Locate well on Section Plat on reverse side)

CONTRACTOR: License # 6451
Name BIG "E" DRILLING
City/State ROUTE 1, CENTERVILLE, KANSAS 66014

Nearest lease or unit boundary line 900 feet
County LINN
Lease Name JOHNSTON Well # 3-87

Well Drilled For: Well Class: Type Equipment:
 Oil Storage Infield Mud Rotary
 Gas Inj Pool Ext. Air Rotary
 OWWO Expl Wildcat Cable

Ground surface elevation feet MSL
Domestic well within 330 feet: yes no
Municipal well within one mile: yes no
Depth to bottom of fresh water 20
Depth to bottom of usable water 150
Surface pipe by Alternate: 1 2
Surface pipe planned to be set 20
Conductor pipe required
Projected Total Depth 700 feet
Formation BARTLESVILLE

If OWWO: old well info as follows:

Operator
Well Name
Comp Date Old Total Depth

I certify that well will comply with K.S.A. 55-101, et seq., plus eventually plugging hole to KCC specifications.

Date 6-30-87 Signature of Operator or Agent Greg Engelman Title AS AGENT

For KCC Use:


Conductor Pipe Required feet; Minimum Surface Pipe Required 20 feet per Alt. X(2)
This Authorization Expires 12-30-87 Approved By Pat 6-30-87

Must be filed with the K.C.C. five (5) days prior to commencing well
This card void if drilling not started within six (6) months of date received by K.C.C.

Important procedures to follow:

1. Notify District office before setting surface casing.
2. Set surface casing by circulating cement to the top.
3. File completion forms ACO-1 with K.C.C. within 120 days of well spud date, following instructions on ACO-1, side 1, and including copies of wireline logs.
4. Notify District office 48 hours prior to old well workover or re-entry.
5. Prior to filing Intent, prepare a proposed plugging plan in case well is D & A, then obtain approval of plan when calling district office prior to setting surface pipe.
6. Submit plugging report (CP-4) to K.C.C. after plugging is completed.
7. Obtain an approved injection docket number before disposing of salt water.
8. Notify K.C.C. within 30 days when injection commences or terminates.
9. If an alternate 2 completion, cement in the production pipe from below any usable water to surface within 120 days of spud date.

**A Regular Section of Land
1 Mile = 5,280 Ft.**

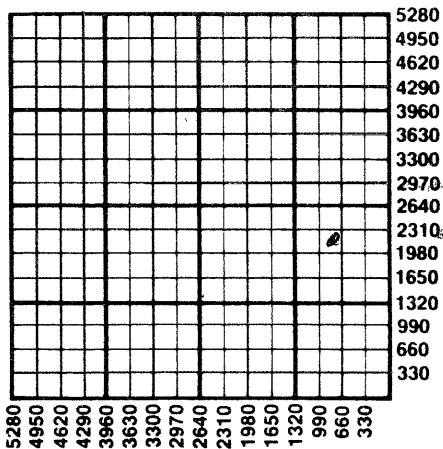

630-87

State Corporation Commission of Kansas
Conservation Division
200 Colorado Derby Building
Wichita, Kansas 67202-1212
(316) 263-3238