

CARD MUST BE TYPED

State of Kansas

CARD MUST BE SIGNED

NOTICE OF INTENTION TO DRILL

(see rules on reverse side)

Expected Spud Date..... JULY 2, 1987.....
month day year

API Number 15- 107-22,872-00-00

OPERATOR: License # #5115

NE NW
NW NE SE Sec. 30 Twp. 22 S, Rg. 22 E ~~West~~

Name REESE EXPLORATION, INC.

2240 Ft. from South Line of Section
1340 Ft. from East Line of Section

Address 5540 RAYTOWN ROAD

City/State/Zip RAYTOWN, MO 64133

(Note: Locate well on Section Plat on reverse side)

Contact Person PATTIE

Phone (816) 356-1970

Nearest lease or unit boundary line 1340 feet

CONTRACTOR: License # 6451

County LINN

Name BIG "E" DRILLING

Lease Name JOHNSTON Well # 4-87

City/State ROUTE 1, CENTERVILLE, KANSAS 66014

Ground surface elevation feet MSL

Well Drilled For: Well Class: Type Equipment:

Domestic well within 330 feet: yes X no

X Oil Storage Infield X Mud Rotary

Municipal well within one mile: yes X no

 Gas Inj X Pool Ext. Air Rotary

Depth to bottom of fresh water..... 20.....

 OWWO Expl Wildcat Cable

Depth to bottom of usable water..... 150.....

If OWWO: old well info as follows:

Surface pipe by Alternate: 1 2X

Operator

Surface pipe planned to be set..... 20.....

Well Name

Conductor pipe required

Comp Date..... Old Total Depth.....

Projected Total Depth..... 700..... feet

I certify that well will comply with K.S.A. 55-101, et seq., plus eventually plugging hole to KCC specifications.

Date 7/2/87 Signature of Operator or Agent Greg Engler Title AS AGENT

For KCC Use:

Conductor Pipe Required feet; Minimum Surface Pipe Required 20 feet per Alt. X(2)


This Authorization Expires 7-2-88 Approved By 7-2-87

Must be filed with the K.C.C. five (5) days prior to commencing well
This card void if drilling not started within six (6) months of date received by K.C.C.

Important procedures to follow:

1. Notify District office before setting surface casing.
2. Set surface casing by circulating cement to the top.
3. File completion forms ACO-1 with K.C.C. within 120 days of well spud date, following instructions on ACO-1, side 1, and including copies of wireline logs.
4. Notify District office 48 hours prior to old well workover or re-entry.
5. Prior to filing Intent, prepare a proposed plugging plan in case well is D & A, then obtain approval of plan when calling district office prior to setting surface pipe.
6. Submit plugging report (CP-4) to K.C.C. after plugging is completed.
7. Obtain an approved injection docket number before disposing of salt water.
8. Notify K.C.C. within 10 days when injection commences or terminates.
9. If an alternate completion, cement in the production pipe from below any usable water to surface within 120 days of spud date.

A Regular Section of Land
1 Mile = 5,280 Ft.

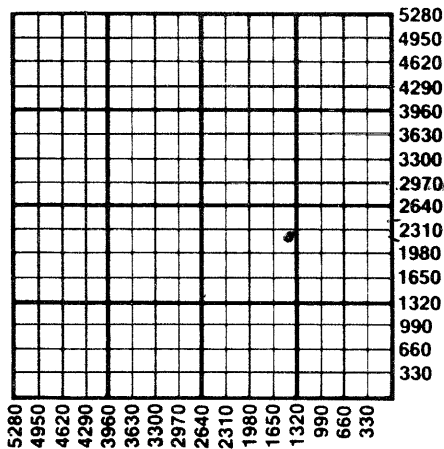

72-87

RECEIVED
STATE CORPORATION COMMISSION
Conservation Division
200 Colorado Derby Building
Wichita, Kansas 67202-1212
(316) 263-3238