

CARD MUST BE TYPED

State of Kansas

CARD MUST BE SIGNED

NOTICE OF INTENTION TO DRILL

(see rules on reverse side)

Starting Date JULY 31, 1987
month day year

API Number 15- 107-22,895-0000 ✓
NW NE X
NE SW SE 30 22 22 — East
Sec. 2000 Twp. S, Rg. — West
1100 Ft. from South Line of Section
Ft. from East Line of Section

OPERATOR: License # 5115
Name REESE EXPLORATION, INC.
Address 5540 RAYTOWN ROAD
City/State/Zip RAYTOWN, MO 64133
Contact Person. PATTIE
Phone (816) 356-1970

(Note: Locate well on Section Plat on reverse side)
Nearest lease or unit boundary line 1300 feet
County LINN
Lease Name JOHNSTON Well # 7-87

CONTRACTOR: License # 6451
Name BIG "E" DRILLING, INC.
City/State ROUTE 1, CENTERVILLE, KS 66014

Ground surface elevation feet MSL
Domestic well within 330 feet: —yes no
Municipal well within one mile: —yes no
Depth to bottom of fresh water 20
Depth to bottom of usable water 150
Surface pipe by Alternate: 1 2
Surface pipe planned to be set 20
Conductor pipe required
Projected Total Depth 700 feet
Formation BARTLESVILLE

Well Drilled For: Well Class: Type Equipment:
— Oil — SWD — Infield — Mud Rotary
— Gas — Inj — Pool Ext. — Air Rotary
— OWWO — Expl — Wildcat — Cable

If OWWO: old well info as follows:
Operator
Well Name
Comp Date Old Total Depth.....

I certify that well will comply with K.S.A. 55-101, et seq., plus eventually plugging hole to KCC specifications.
Date 7/30/87 Signature of Operator or Agent [Signature] Title AS AGENT


For KCC Use:
Conductor Pipe Required feet; Minimum Surface Pipe Required 20 feet per Alt. X 2
This Authorization Expires 1-30-88 Approved By P.H. 7-30-87

Must be filed with the K.C.C. five (5) days prior to commencing well
This card void if drilling not started within six (6) months of date received by K.C.C.

Important procedures to follow:

1. Notify District office before setting surface casing.
2. Set surface casing by circulating cement to the top.
3. File completion forms ACO-1 with K.C.C. within 90 days of well completion, following instructions on ACO-1, side 1, and including copies of wireline logs.
4. Notify District office 48 hours prior to old well workover or re-entry.
5. Prior to filing Intent, prepare a proposed plugging plan in case well is D & A, then obtain approval of plan when calling district office prior to setting surface pipe.
6. Submit plugging report (CP-4) to K.C.C. after plugging is completed.
7. Obtain an approved injection docket number before disposing of salt water.
8. Notify K.C.C. within 10 days when injection commences or terminates.
9. If an alternate 2 completion, cement in the production pipe from below any usable water to surface within 120 days of spud date.

**A Regular Section of Land
1 Mile = 5,280 Ft.**

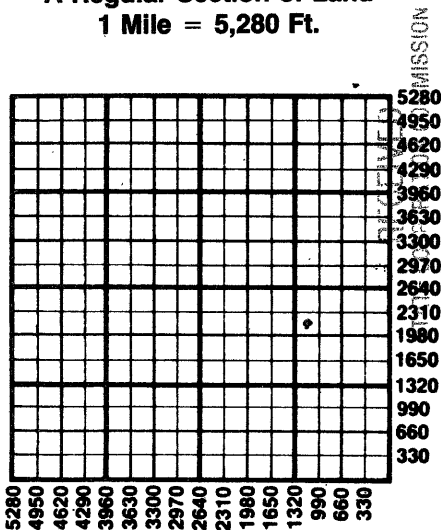

JUL 30 1987

CONSERVATION DIVISION
Wichita, Kansas

7-30-87

State Corporation Commission of Kansas
Conservation Division
200 Colorado Derby Building
Wichita, Kansas 67202
(316) 262-2200