

CARD MUST BE TYPED

State of Kansas
NOTICE OF INTENTION TO DRILL
(see rules on reverse side)

CARD MUST BE SIGNED

Starting Date: 4 9 85
month day year

API Number 15- 107-22,527-0000

OPERATOR: License # 9863

... SW . SW NE Sec . 5 . Twp 22 . S, Rge . 23 East
(location) West

Name Pacesetter Oil, Inc.

Address Box 216

City/State/Zip Mound City, KS 66056

Contact Person Gib McGown

Phone (913) 795 2258

..... 297.0 Ft North from Southeast Corner of Section

..... 227.5 Ft West from Southeast Corner of Section

(Note: Locate well on Section Plat on reverse side)

CONTRACTOR: License # 5786

Nearest lease or unit boundary line 365 feet.

County Linn

Name McGown Drilling, Inc.

Lease Name Kettler Well# 2

City/State Mound City, KS 66056

Domestic well within 330 feet: yes no

Municipal well within one mile: yes no

Well Drilled For:

Well Class:

Type Equipment:

Oil Swd

Infield

Mud Rotary

Gas Inj

Pool Ext.

Air Rotary

OWWO Expl

Wildcat

Cable

If OWWO: old well info as follows:

Operator

Well Name

Comp Date Old Total Depth

Projected Total Depth 700 feet

Projected Formation at TD

Expected Producing Formations

Depth to Bottom of fresh water ... 65 feet

Lowest usable water formation

Depth to Bottom of usable water ... 150 feet

Surface pipe by Alternate: 1 2

Surface pipe to be set 20 feet

Conductor pipe if any required

Ground surface elevation feet MSL

This Authorization Expires 10-8-85

Approved By RCH/KCC 4-8-85

I certify that we will comply with K.S.A. 55-101, et seq., plus eventually plugging hole to K.C.C. specifications.

Date .. 4/8/85 Signature of Operator or Agent

Raqueel Robles

Title As Agent

m HCUOHE 4-9-85


Must be filed with the K.C.C. five (5) days prior to commencing well
This card void if drilling not started within six (6) months of date received by K.C.C.

RECEIVED
STATE CORPORATION COMMISSION

4-8-85
~~8-8~~

APR 8 1985

A Regular Section of Land
OBSERVATION DIVISION
1 Mile 5,280 Ft.
Wichita, Kansas

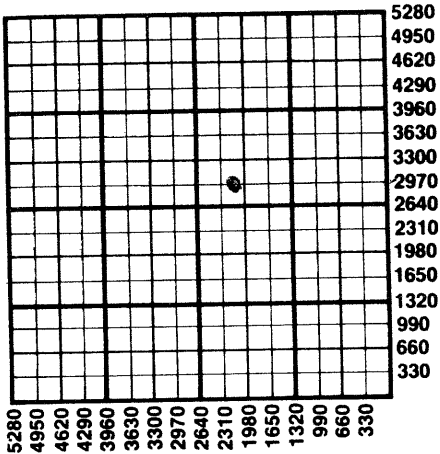

Important procedures to follow :

1. Notify District office before setting surface casing.
2. Set surface casing by circulating cement to the top.
3. File completion forms ACO-1 with K.C.C. within 90 days of well completion, following instructions on ACO-1, side 1, and including copies of wireline logs.
4. Notify District office 48 hours prior to old well workover or re-entry.
5. Prior to plugging, prepare a plugging plan, then obtain agreement from the appropriate district office for an approved plugging plan.
6. Submit plugging report (CP-4) to K.C.C. after plugging is completed.
7. Obtain an approved injection docket number before disposing of salt water.
8. Notify K.C.C. within 10 days when injection commences or terminates.
9. If an alternate 2 completion, cement in the production pipe from below any usable water to surface within 120 days of spud date.

State Corporation Commission of Kansas
Conservation Division
200 Colorado Derby Building
Wichita, Kansas 67202
(316) 263-3238