

CARD MUST BE TYPED

State of Kansas

CARD MUST BE SIGNED

NOTICE OF INTENTION TO DRILL

(see rules on reverse side)

Expected Spud Date..... June 1, 1987.....
month day year

API Number 15— 107-22,858-00-100 ✓

OPERATOR: License #..... 6451.....

NE NE NW Sec. 19 Twp. 22 S, Rg. 22 — East
5115 — West

Name Big "E" Drilling.....

Address Route 1.....

City/State/Zip Centerville, Kansas 66014.....

Contact Person..... Mike Eastwood.....

Phone..... (913) 898-4082.....

..... 2805 Ft. from South Line of Section
..... Ft. from East Line of Section

(Note: Locate well on Section Plat on reverse side)

Nearest lease or unit boundary line 165 feet

County..... Linn.....

Lease Name..... Miller..... Well #..... 1-87.....

CONTRACTOR: License #.....

Ground surface elevation feet MSL

Name Company Tools.....

Domestic well within 330 feet: yes no

City/State.....

Municipal well within one mile: yes no

Well Drilled For: Well Class: Type Equipment:

Depth to bottom of fresh water.....

Oil Storage Infield Mud Rotary

Depth to bottom of usable water 150

Gas Inj Pool Ext. Air Rotary

Surface pipe by Alternate: 1 2

OWWO Expl Wildcat Cable

Surface pipe planned to be set 20

If OWWO: old well info as follows:

Conductor pipe required

Operator

Projected Total Depth 800 feet

Well Name

Formation Stark Shale

Comp Date Old Total Depth.....

I certify that well will comply with K.S.A. 55-101, et seq., plus eventually plugging hole to KCC specifications.

Date 5/29/87..... Signature of Operator or Agent Greg Engeman Title AS AGENT.....

For KCC Use:

Conductor Pipe Required feet; Minimum Surface Pipe Required 20 feet per Alt. 102


This Authorization Expires 11-29-87..... Approved By 5-29-87..... EC

Must be filed with the K.C.C. five (5) days prior to commencing well
This card void if drilling not started within six (6) months of date received by K.C.C.

Important procedures to follow:

1. Notify District office before setting surface casing.
2. Set surface casing by circulating cement to the top.
3. File completion forms ACO-1 with K.C.C. within 120 days of well spud date, following instructions on ACO-1, side 1, and including copies of wireline logs.
4. Notify District office 48 hours prior to old well workover or re-entry.
5. Prior to filing Intent, prepare a proposed plugging plan in case well is D & A, then obtain approval of plan when calling district office prior to setting surface pipe.
6. Submit plugging report (CP-4) to K.C.C. after plugging is completed.
7. Obtain an approved injection docket number before disposing of salt water.
8. Notify K.C.C. within 10 days when injection commences or terminates.

**A Regular Section of Land
1 Mile = 5,280 Ft.**

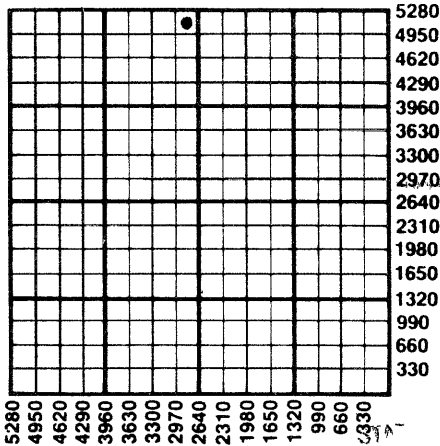

RECEIVED

9. Alternate 2 completion, cement in the production pipe from below any usable water to surface within 120 days of spud date.

MAY 20 1987
5-29-87
Wichita, Kansas

State Corporation Commission of Kansas
Conservation Division
200 Colorado Derby Building
Wichita, Kansas 67202-1212
(316) 263-3238