

CARD MUST BE TYPED

State of Kansas

CARD MUST BE SIGNED

NOTICE OF INTENTION TO DRILL

(see rules on reverse side)

Expected Spud Date..... June 3, 1987
month day year

API Number 15— 107-22,859-00-00 ✓

OPERATOR: License # 6451

NE NE NW Sec. 19 Twp. 22 S, Rg. 22 East West

Name Big E Drilling
Address Route 1

5115 Ft. from South Line of Section
3135 Ft. from East Line of Section

City/State/Zip Centerville, Kansas 66014

(Note: Locate well on Section Plat on reverse side)

Contact Person Mike Eastwood
Phone (913) 898-4082

Nearest lease or unit boundary line ... 1.65 feet
County Linn

CONTRACTOR: License #
Name Company Tools

Lease Name Miller Well # 2-87
Ground surface elevation feet MSL

City/State

Well Drilled For: Well Class: Type Equipment:
 Oil Storage Infield Mud Rotary
 Gas Inj Pool Ext. Air Rotary
 OWWO Expl Wildcat Cable

Domestic well within 330 feet: yes no

Municipal well within one mile: yes no

If OWWO: old well info as follows:

Operator
Well Name
Comp Date Old Total Depth

Depth to bottom of fresh water

Depth to bottom of usable water 150

Surface pipe by Alternate: 20 1 2

Surface pipe planned to be set

Conductor pipe required

Projected Total Depth 800 feet

Formation Stark Shale

I certify that well will comply with K.S.A. 55-101, et seq., plus eventually plugging hole to KCC specifications.
Date 5/29/87 Signature of Operator or Agent Greg Engleman Title As Agent


For KCC Use:
Conductor Pipe Required feet; Minimum Surface Pipe Required 20 feet per Alt.
This Authorization Expires 11-29-87 Approved By 5-29-87

Must be filed with the K.C.C. five (5) days prior to commencing well
This card void if drilling not started within six (6) months of date received by K.C.C.

Important procedures to follow:

1. Notify District office before setting surface casing.
2. Set surface casing by circulating cement to the top.
3. File completion forms ACO-1 with K.C.C. within 120 days of well spud date, following instructions on ACO-1, side 1, and including copies of wireline logs.
4. Notify District office 48 hours prior to old well workover or re-entry.
5. Prior to filing Intent, prepare a proposed plugging plan in case well is D & A, then obtain approval of plan when calling district office prior to setting surface pipe.
6. Submit plugging report (CP-4) to K.C.C. after plugging is completed.
7. Obtain an approved injection docket number before disposing of salt water.
8. Notify K.C.C. within 10 days when injection commences or terminates.
9. If an alternate 2 completion, cement in the production pipe from below any usable water to surface within 120 days of spud date.

A Regular Section of Land
1 Mile = 5,280 Ft.

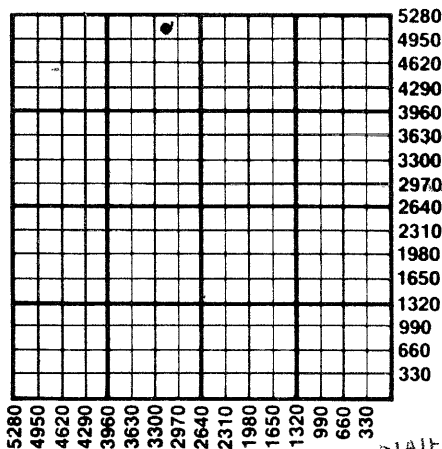

5-29-87

RECEIVED
MAY 29 1987
CONSERVATION DIVISION
Wichita, Kansas

State Corporation Commission of Kansas
Conservation Division
200 Colorado Derby Building
Wichita, Kansas 67202-1212
(316) 263-3238