

CARD MUST BE TYPED

State of Kansas

CARD MUST BE SIGNED

NOTICE OF INTENTION TO DRILL

(see rules on reverse side)

Expected Spud Date.....9.....22.....1987.....
month day year

API Number 15— 107-22,910-00-00 ✓
X East

OPERATOR: License # 3445
Name Circle M Resources
Address Box 64
City/State/Zip Mound City, Kans. 66056
Contact Person..... Nancy Miller
Phone..... (913) 756-2319

NW. NE. NW. Sec. 19. Twp. 22. S, Rg. 22. ... West
4815 Ft. from South Line of Section
3405 Ft. from East Line of Section

(Note: Locate well on Section Plat on reverse side)

CONTRACTOR: License # 6451
Name Big "E" Drilling
City/State..... Centerville, Kans. 66014

Nearest lease or unit boundary line 465 feet
County..... LINN

Well Drilled For: Well Class: Type Equipment:
X Oil ___ Storage X Infield ___ Mud Rotary
___ Gas ___ Inj ___ Pool Ext. X Air Rotary
___ OWWO ___ Expl ___ Wildcat ___ Cable

Lease Name..... MILLER Well # 6-87
Ground surface elevation feet MSL

If OWWO: old well info as follows:
Operator
Well Name
Comp Date..... Old Total Depth.....

Domestic well within 330 feet: ___ yes X no
Municipal well within one mile: ___ yes X no
Depth to bottom of fresh water 20
Depth to bottom of usable water 150

I certify that well will comply with K.S.A. 55-101, et seq., plus eventually plugging hole to KCC specifications.
Date .. 9-18-87 Signature of Operator or Agent *Frank Shugart* Title..... Agent


For KCC Use:
Conductor Pipe Required feet; Minimum Surface Pipe Required 20 feet per Alt. X (2)
This Authorization Expires 9-18-88 Effective 9-23-87 Approved By Per 9-18-87

Must be filed with the K.C.C. five (5) days prior to commencing well
This card void if drilling not started within six (6) months of date received by K.C.C.

Important procedures to follow:

1. Notify District office before setting surface casing.
2. Set surface casing by circulating cement to the top.
3. File completion forms ACO-1 with K.C.C. within 120 days of well spud date, following instructions on ACO-1, side 1, and including copies of wireline logs.
4. Notify District office 48 hours prior to old well workover or re-entry.
5. Prior to filing Intent, prepare a proposed plugging plan in case well is D & A, then obtain approval of plan when calling district office prior to setting surface pipe.
6. Submit plugging report (CP-4) to K.C.C. after plugging is completed.
7. Obtain an approved injection docket number before disposing of salt water.
8. Notify K.C.C. within 10 days when injection commences or terminates.
9. If an alternate 2 completion, cement in the production pipe from below any usable water to surface within 120 days of spud date.

A Regular Section of Land
1 Mile = 5,280 Ft.

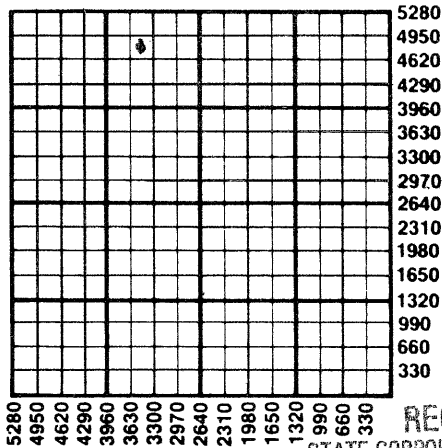

RECEIVED
STATE CORPORATION COMMISSION

SEP 18 1987

CONSERVATION DIVISION
Wichita, Kansas

CP-18-87

State Corporation Commission of Kansas
Conservation Division
200 Colorado Derby Building
Wichita, Kansas 67202-1212
(316) 263-3238