

CARD MUST BE TYPED

State of Kansas

CARD MUST BE SIGNED

NOTICE OF INTENTION TO DRILL

(see rules on reverse side)

Expected Spud Date..... 6 22 1988
month day year

API Number 15-107-23002-0000
SE NE NW Sec. 19 Twp. 22 S, Rg. 22 East
4510 _____ Ft. from South Line of Section
3060 _____ Ft. from East Line of Section

OPERATOR: License # 3523
Name KERR MANAGEMENT
Address 9701 E. Arapahoe Road
City/State/Zip Englewood, Colorado 80112
Contact Person Bob Sadler
Phone (913) 756-2223

(Note: Locate well on Section Plat on reverse side)
Nearest lease or unit boundary line 465 feet
County LINN
Lease Name MILLER Well # 8-88

CONTRACTOR: License # 6451
Name Big "E" Drilling
City/State Centerville, Kans. 66014

Ground surface elevation _____ feet MSL
Domestic well within 330 feet: _____yes no
Municipal well within one mile: _____yes no
Depth to bottom of fresh water 20
Depth to bottom of usable water 150
Surface pipe by Alternate: 1 _____ 2
Surface pipe planned to be set 20
Conductor pipe required None
Projected Total Depth 900 feet
Formation Bartlesville

Well Drilled For: Well Class: Type Equipment:
 Oil _____ Storage _____ Infield _____ Mud Rotary
_____ Gas _____ Inj Pool Ext. Air Rotary
_____ OWWO _____ Expl _____ Wildcat _____ Cable

IF OWWO: old well info as follows:

Operator _____
Well Name _____
Comp Date _____ Old Total Depth _____

I certify that well will comply with K.S.A. 55-101, et seq., plus eventually plugging hole to KCC specifications.

Date 6-17-88 Signature of Operator or Agent *Frank Bradford* Title Agent

For KCC Use:

Conductor Pipe Required _____ feet; Minimum Surface Pipe Required 20 feet per Alt.
This Authorization Expires 12-17-88 Approved By *get 12-17-88*


EFFECTIVE DATE: 6-22-88

Must be filed with the K.C.C. five (5) days prior to commencing well
This card void if drilling not started within six (6) months of date received by K.C.C.

Important procedures to follow:

1. Notify District office before setting surface casing.
2. Set surface casing by circulating cement to the top.
3. File completion forms ACO-1 with K.C.C. within 120 days of well spud date, following instructions on ACO-1, side 1, and including copies of wireline logs.
4. Notify District office 48 hours prior to old well workover or re-entry.
5. Prior to filing Intent, prepare a proposed plugging plan in case well is D & A, then obtain approval of plan when calling district office prior to setting surface pipe.
6. Submit plugging report (CP-4) to K.C.C. after plugging is completed.
7. Obtain an approved injection docket number before disposing of salt water.
8. Notify K.C.C. within 10 days when injection commences or terminates.
9. If an alternate 2 completion, cement in the production pipe from below any usable water to surface within 120 days of spud date.

A Regular Section of Land 1 Mile = 5,280 Ft.

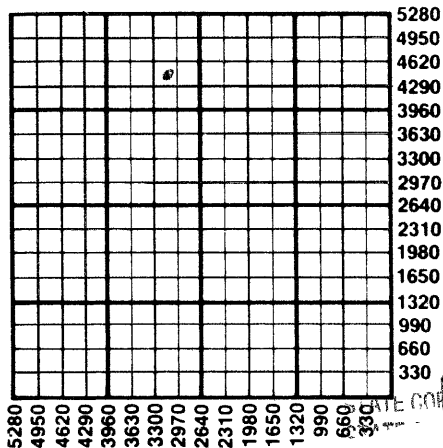

CONSERVATION DIVISION
Wichita, Kansas

6-17-88

State Corporation Commission of Kansas
Conservation Division
200 Colorado Derby Building
Wichita, Kansas 67202-1212
(316) 263-3238