

CARD MUST BE TYPED

State of Kansas

CARD MUST BE SIGNED

NOTICE OF INTENTION TO DRILL

(see rules on reverse side)

Expected Spud Date..... 6 22 1988
month day year

API Number 15-107-23,005-00-00

OPERATOR: License # 3523
Name KERR MANAGEMENT
Address 9701 E. Arapahoe Road
City/State/Zip Englewood, Colo. 80112
Contact Person Bob Sadler
Phone (913) 756-2223

SE NE NW Sec. 19 Twp. 22 S, Rg. 22
4295 _____ East
2855 _____ West
Ft. from South Line of Section
Ft. from East Line of Section

(Note: Locate well on Section Plat on reverse side)

CONTRACTOR: License # 6451
Name Big "E" Drilling
City/State Centerville, Kans. 66041

Nearest lease or unit boundary line 165 feet
County LINN
Lease Name MILLER Well # 11-88

Well Drilled For: Well Class: Type Equipment:
___ Oil ___ Storage Infield ___ Mud Rotary
___ Gas Inj ___ Pool Ext. Air Rotary
___ OWWO ___ Expl ___ Wildcat ___ Cable

Ground surface elevation _____ feet MSL
Domestic well within 330 feet: ___yes no
Municipal well within one mile: ___yes no
Depth to bottom of fresh water 20
Depth to bottom of usable water 150
Surface pipe by Alternate: 1 ___ 2
Surface pipe planned to be set 20
Conductor pipe required None
Projected Total Depth 900 feet
Formation Bartlesville

IF OWWO: old well info as follows:
Operator _____
Well Name _____
Comp Date _____ Old Total Depth _____

I certify that well will comply with K.S.A. 55-101, et seq., plus eventually plugging hole to KCC specifications.
Date _____ Signature of Operator or Agent _____ Title _____ Agent _____


For KCC Use:
Conductor Pipe Required _____ feet; Minimum Surface Pipe Required _____ feet per Alt. 2
This Authorization Expires 12-17-88 Approved By Bert 6-17-88

Must be filed with the K.C.C. five (5) days prior to commencing well
 This card void if drilling not started within six (6) months of date received by K.C.C.

Important procedures to follow:

1. Notify District office before setting surface casing.
2. Set surface casing by circulating cement to the top.
3. File completion forms ACO-1 with K.C.C. within 120 days of well spud date, following instructions on ACO-1, side 1, and including copies of wireline logs.
4. Notify District office 48 hours prior to old well workover or re-entry.
5. Prior to filing Intent, prepare a proposed plugging plan in case well is D & A, then obtain approval of plan when calling district office prior to setting surface pipe.
6. Submit plugging report (CP-4) to K.C.C. after plugging is completed.
7. Obtain an approved injection docket number before disposing of salt water.
8. Notify K.C.C. within 10 days when injection commences or terminates.
9. If an alternate 2 completion, cement in the production pipe from below any usable water to surface within 120 days of spud date.

**A Regular Section of Land
 1 Mile = 5,280 Ft.**

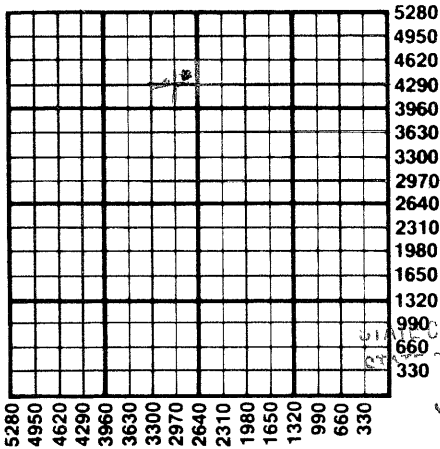

RECEIVED
 STATE CORPORATION COMMISSION
 JUN 17 1988

Conservation Division
 Wichita, Kansas

6-17-88

State Corporation Commission of Kansas
 Conservation Division
 200 Colorado Derby Building
 Wichita, Kansas 67202-1212
 (316) 263-3238