

CARD MUST BE TYPED

State of Kansas

CARD MUST BE SIGNED

NOTICE OF INTENTION TO DRILL

(see rules on reverse side)

Expected Spud Date..... 12 20 1988
month day year

API Number 15- 107-23,027-00-00

OPERATOR: License # 5115
Name REESE EXPLORATION, INC.
Address 6220 Arlington
City/State/Zip Raytown, Missouri 64133
Contact Person Patty Eichman
Phone (816) 356-1970

NW NW NW Sec. 20 Twp. 22 S, Rg. 22 East
5060 _____ West
5060 _____ Ft. from South Line of Section
_____ Ft. from East Line of Section

(Note: Locate well on Section Plat on reverse side)

CONTRACTOR: License # 5868
Name Lewis Drilling
City/State Bronson, Kansas 66716

Nearest lease or unit boundary line 220 feet
County LINN
Lease Name ROBERT WEST Well # 1-88

Well Drilled For: Well Class: Type Equipment:
 Oil _____ Storage _____ Infield Mud Rotary
_____ Gas _____ Inj. _____ Pool Ext. _____ Air Rotary
_____ OWWO _____ Expl Wildcat _____ Cable

Ground surface elevation feet MSL
Domestic well within 330 feet: _____ yes no
Municipal well within one mile: _____ yes no
Depth to bottom of fresh water 20
Depth to bottom of usable water 150
Surface pipe by Alternate: 1 _____ 2
Surface pipe planned to be set 20
Conductor pipe required 0
Projected Total Depth 700 feet
Formation Bartlesville

If OWWO: old well info as follows:
Operator
Well Name
Comp Date 12-15-88 Old Total Depth.....

I certify that well will comply with K.S.A. 55-101, et seq., plus eventually plugging hole to KCC specifications.
Date Signature of Operator or Agent *Patty Eichman* Title.....

For KCC Use:
Conductor Pipe Required feet; Minimum Surface Pipe Required 20 feet per Alt. 2
This Authorization Expires 10-15-89 Approved By *Patt. 12-15-88*


EXPIRE DATE: 12-20-88

Must be filed with the K.C.C. five (5) days prior to commencing well
 This card void if drilling not started within six (6) months of date received by K.C.C.

Important procedures to follow:

1. Notify District office before setting surface casing.
2. Set surface casing by circulating cement to the top.
3. File completion forms ACO-1 with K.C.C. within 120 days of well spud date, following instructions on ACO-1, side 1, and including copies of wireline logs.
4. Notify District office 48 hours prior to old well workover or re-entry.
5. Prior to filing Intent, prepare a proposed plugging plan in case well is D & A, then obtain approval of plan when calling district office prior to setting surface pipe.
6. Submit plugging report (CP-4) to K.C.C. after plugging is completed.
7. Obtain an approved injection docket number before disposing of salt water.
8. Notify K.C.C. within 10 days when injection commences or terminates.
9. If an alternate 2 completion, cement in the production pipe from below any usable water to surface within 120 days of spud date.

**A Regular Section of Land
 1 Mile = 5,280 Ft.**

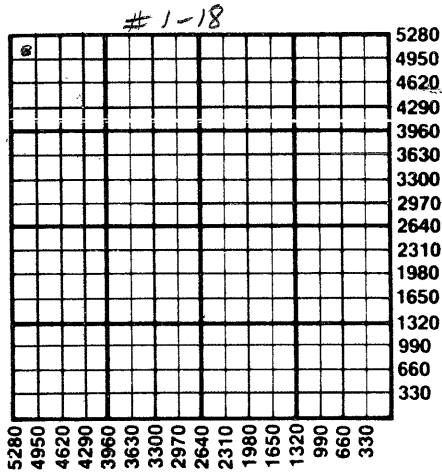

12-15-88

RECEIVED
 STATE CORPORATION COMMISSION
 WICHITA, KANSAS
 DEC 15 1988
 CONSERVATION DIVISION
 WICHITA, KANSAS

State Corporation Commission of Kansas
 Conservation Division
 200 Colorado Derby Building
 Wichita, Kansas 67202-1212
 (316) 263-3238