

CARD MUST BE TYPED

State of Kansas

CARD MUST BE SIGNED

### NOTICE OF INTENTION TO DRILL

(see rules on reverse side)

Expected Spud Date..... 12 month 20 day 1988 year

API Number 15— 107-23,028-00-00 ✓

OPERATOR: License # ..... 5115

SW NW NW Sec. 20 Twp. 22 S, Rg. 22  East

Name ..... REESE EXPLORATION, INC.

4180 ..... Ft. from South Line of Section

Address ..... 6220 Arlington

5060 ..... Ft. from East Line of Section

City/State/Zip ..... Raytown, Missouri 64133

Contact Person..... Patty Eichman

Phone..... (816) 356-1970

CONTRACTOR: License # ..... 5868

Name ..... Lewis Drilling

City/State..... Bronson, Kansas 66716

Well Drilled For: Well Class: Type Equipment:

Oil  Storage  Infield  Mud Rotary  
 Gas  Inj  Pool Ext.  Air Rotary  
 OWWO  Expl  Wildcat  Cable

(Note: Locate well on Section Plat on reverse side)

Nearest lease or unit boundary line ..... 220 ..... feet

County..... LINN

Lease Name..... ROBERT WEST Well # .. 2-88

Ground surface elevation ..... feet MSL

Domestic well within 330 feet:  yes  no

Municipal well within one mile:  yes  no

Depth to bottom of fresh water ..... 20

Depth to bottom of usable water ..... 150

Surface pipe by Alternate: 1  2

Surface pipe planned to be set ..... 20

Conductor pipe required ..... 0

Projected Total Depth ..... 700 ..... feet

Formation..... Bartlesville

If OWWO: old well info as follows:

Operator .....

Well Name .....

Comp Date..... Old Total Depth.....

I certify that well will comply with K.S.A. 55-101, et seq., plus eventually plugging hole to KCC specifications.

Date 12-15-88 Signature of Operator or Agent *[Signature]* Title..... Agent

For KCC Use:

Conductor Pipe Required ..... feet; Minimum Surface Pipe Required ..... 20 feet per Alt. X (2)

This Authorization Expires 12-15-88 Approved By ROH 12-15-88


12-20-88

Must be filed with the K.C.C. five (5) days prior to commencing well  
 This card void if drilling not started within six (6) months of date received by K.C.C.

**Important procedures to follow:**

1. Notify District office before setting surface casing.
2. Set surface casing by circulating cement to the top.
3. File completion forms ACO-1 with K.C.C. within 120 days of well spud date, following instructions on ACO-1, side 1, and including copies of wireline logs.
4. Notify District office 48 hours prior to old well workover or re-entry.
5. Prior to filing Intent, prepare a proposed plugging plan in case well is D & A, then obtain approval of plan when calling district office prior to setting surface pipe.
6. Submit plugging report (CP-4) to K.C.C. after plugging is completed.
7. Obtain an approved injection docket number before disposing of salt water.
8. Notify K.C.C. within 10 days when injection commences or terminates.
9. If an alternate 2 completion, cement in the production pipe from below any usable water to surface within 120 days of spud date.

**A Regular Section of Land**  
**1 Mile = 5,280 Ft.**

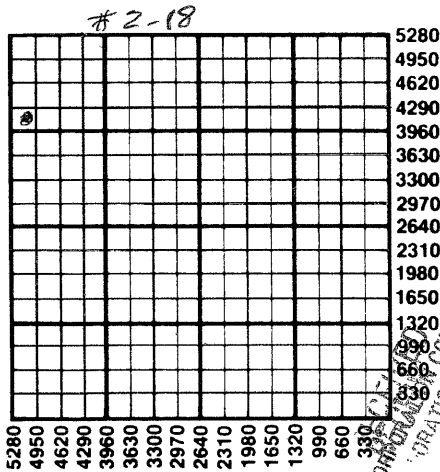

STATE CORPORATION COMMISSION  
 WICHITA, KANSAS  
 DEC 15 1988  
 CONSERVATION DIVISION  
 WICHITA, KANSAS

12-15-88

State Corporation Commission of Kansas  
 Conservation Division  
 200 Colorado Derby Building  
 Wichita, Kansas 67202-1212  
 (316) 263-3238