CARD MUST BE TYPED

State of Kansas

CARD MUST BE SIGNED

NOTICE OF INTENTION TO DRILL

(see rules on reverse side)

Expected Spud Date..... 5 (month) 11 (day) 87 (year)

API Number 15— 107-22,850-00-00

OPERATOR: License # 5648

Name ..... Roy W. Cook

Address ..... Box 296

City/State/Zip ..... Colony, Kansas 66015

Contact Person ..... same

Phone 316-852-3544

CONTRACTOR: License # 5379

Name ..... Kephart Drilling

City/State ..... Thayer, Kansas

Well Drilled For:		Well Class:	Type Equipment:
X Oil	___ Storage	___ Infield	___ Mud Rotary
___ Gas	___ Inj	___ Pool Ext.	X Air Rotary
___ OWWO	___ Expl	X Wildcat	___ Cable

If OWWO: old well info as follows:

Operator .....

Well Name .....

Comp Date ..... Old Total Depth .....

SE SE SE Sec. 2 Twp. 23 S, Rg. 23 X East ___ West

495 Ft. from South Line of Section

536 Ft. from East Line of Section

(Note: Locate well on Section Plat on reverse side)

Nearest lease or unit boundary line ..... 495 ..... feet

County ..... Linn

Lease Name ..... Cox ..... Well # 1

Ground surface elevation ..... 1000 ..... feet MSL

Domestic well within 330 feet: ___ yes X no

Municipal well within one mile: ___ yes X no

Depth to bottom of fresh water 14

Depth to bottom of usable water 150

Surface pipe by Alternate: 1 ___ 2 X

Surface pipe planned to be set 20

Conductor pipe required .....

Projected Total Depth ..... 650 ..... feet

Formation ..... Bartelsville

I certify that well will comply with K.S.A. 55-101, et seq., plus eventually plugging hole to KCC specifications.

Date 5/4/87 Signature of Operator or Agent ..... Title Owner

For KCC Use:


Conductor Pipe Required ..... feet; Minimum Surface Pipe Required ..... 20 ..... feet per Alt. 4 (2)

This Authorization Expires ..... 11-6-87 ..... Approved By 5-6-87

Must be filed with the K.C.C. five (5) days prior to commencing well
This card void if drilling not started within six (6) months of date received by K.C.C.

A Regular Section of Land
1 Mile = 5,280 Ft.

S-16-87

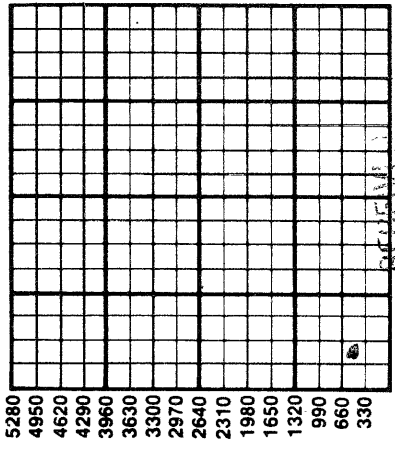

RECEIVED
STATE CORPORATION COMMISSION
MAY 6 1987
CONSERVATION DIVISION
Wichita, Kansas

Important procedures to follow:

1. Notify District office before setting surface casing.
2. Set surface casing by circulating cement to the top.
3. File completion forms ACO-1 with K.C.C. within 120 days of well spud date, following instructions on ACO-1, side 1, and including copies of wireline logs.
4. Notify District office 48 hours prior to old well workover or re-entry.
5. Prior to filing Intent, prepare a proposed plugging plan in case well is D & A, then obtain approval of plan when calling district office prior to setting surface pipe.
6. Submit plugging report (CP-4) to K.C.C. after plugging is completed.
7. Obtain an approved injection docket number before disposing of salt water.
8. Notify K.C.C. within 10 days when injection commences or terminates.
9. If an alternate 2 completion, cement in the production pipe from below any usable water to surface within 120 days of spud date.

State Corporation Commission of Kansas
Conservation Division
200 Colorado Derby Building
Wichita, Kansas 67202-1212
(316) 263-3238