

CARD MUST BE TYPED

State of Kansas

CARD MUST BE SIGNED

NOTICE OF INTENTION TO DRILL

(see rules on reverse side)

CORRECTION

10-22-85

Starting Date 10.....21.....1985.....
month day year

API Number 15— 107-22,764 0000

OPERATOR: License # 6451 App. SW ~~N~~ NE. Sec. 10 ... Twp. 23 ... S, Rg. 22 ... East

..... 4180 Ft. from South Line of Section

Name Big. E. Drilling. Company.....

..... 2420 Ft. from East Line of Section

Address Route 1.....

City/State/Zip Centerville, KS. 66014.....

Contact Person..... Mike Eastwood.....

Phone 913. 898. 4082.....

(Note: Locate well on Section Plat on reverse side)

Nearest lease or unit boundary line . 220 feet

CONTRACTOR: License #

Name Company. tools.....

City/State

Well Drilled For: Well Class: Type Equipment:

Oil SWD Infield Mud Rotary
 Gas Inj Pool Ext. Air Rotary
 OWWO Expl Wildcat Cable

If OWWO: old well info as follows:

Operator

Well Name

Comp Date Old Total Depth.....

I certify that well will comply with K.S.A. 55-101, et seq., plus eventually plugging hole to KCC specifications.

_____ cementing will be done immediately upon setting production casing.

Date ... 10-21/85 ... Signature of Operator or Agent Oliver Garbain Title as agent..

For KCC Use:

Conductor Pipe Required feet; Minimum Surface Pipe Required feet per Alt. 1 2

This Authorization Expires 4-3-86 Approved By 10-2-85

Must be filed with the K.C.C. five (5) days prior to commencing well
This card void if drilling not started within six (6) months of date received by K.C.C.

10-21-85


Important procedures to follow:

A Regular Section of Land
1 Mile = 5,280 Ft.

RECEIVED
STATE CORPORATION COMMISSION

OCT 21 1985

CONSERVATION DIVISION
Wichita, Kansas

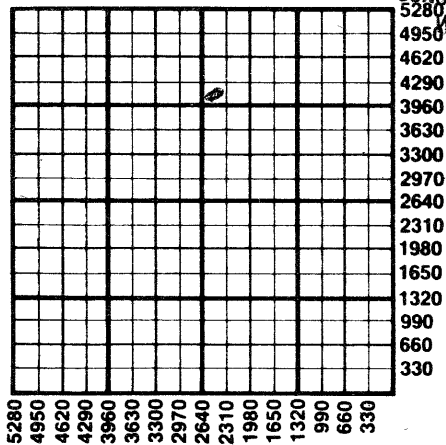

1. Notify District office before setting surface casing.
2. Set surface casing by circulating cement to the top.
3. File completion forms ACO-1 with K.C.C. within 90 days of well completion, following instructions on ACO-1, side 1, and including copies of wireline logs.
4. Notify District office 48 hours prior to old well workover or re-entry.
5. Prior to filing Intent, prepare a proposed plugging plan in case well is D & A, then obtain approval of plan when calling district office prior to setting surface pipe.
6. Submit plugging report (CP-4) to K.C.C. after plugging is completed.
7. Obtain an approved injection docket number before disposing of salt water.
8. Notify K.C.C. within 10 days when injection commences or terminates.
9. If an alternate 2 completion, cement in the production pipe from below any usable water to surface within 120 days of spud date.

State Corporation Commission of Kansas
Conservation Division
200 Colorado Derby Building
Wichita, Kansas 67202
(316) 263-3238