

CARD MUST BE TYPED

State of Kansas
NOTICE OF INTENTION TO DRILL
(see rules on reverse side)

CARD MUST BE SIGNED

Starting Date: 12 11 84
month day year 1120

API Number 15- 037-21,308-100-00

OPERATOR: License # 5602

SWSW SE. ... Sec . 29 Twp . 27S, Rge . 22 East
(location) West

Name N & B Enterprises

Address Box 884

City/State/Zip Chanute, KS 66720

Contact Person Edd Noland

Phone 316 431-9210

..... 330 Ft North from Southeast Corner of Section
..... 2310 Ft West from Southeast Corner of Section
(Note: Locate well on Section Plat on reverse side)

CONTRACTOR: License # 5677

Name J. R. Burris Drilling Co.

City/State Box 345, Iola, KS 66749

Nearest lease or unit boundary line 330 feet.
County Crawford

Lease Name Parker Well# .. NB-1 ..

Domestic well within 330 feet : yes no

Municipal well within one mile : yes no

Well Drilled For: Well Class: Type Equipment:

- Oil Swd Field Wind Rotary
- Gas Inj Pool Ext. Air Rotary
- OWWO Expl Wildcat Cable

Depth to Bottom of fresh water 20 feet

Lowest usable water formation

Depth to Bottom of usable water 100 feet

Surface pipe by Alternate : 1 2

Surface pipe to be set 20 feet

Conductor pipe if any required

Ground surface elevation feet MSL

This Authorization Expires 6-11-85

Approved By 12-11-84 *R*

If OWWO: old well info as follows:

Operator

Well Name

Comp Date Old Total Depth

Projected Total Depth 700 feet

Projected Formation at TD

Expected Producing Formations

I certify that we will comply with K.S.A. 55-101, et seq., plus eventually plugging hole to K.C.C. specifications.

Date 12/11/84.. Signature of Operator or Agent

Reguel Tobias

Title As Agent

Form C-1 4/84

MHC/WOHE 12/11/84

Must be filed with the K.C.C. five (5) days prior to commencing well
This card void if drilling not started within six (6) months of date received by K.C.C.


CONSERVATION DIVISION
Wichita, Kansas

DEC 11 1984

12-11-84

Important procedures to follow :

STATE CORPORATION COMMISSION
A Regular Section of Land
1 Mile = 5,280 Ft.

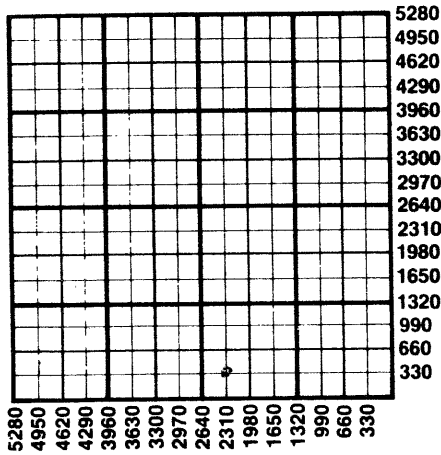

1. Notify District office before setting surface casing.
2. Set surface casing by circulating cement to the top.
3. File completion forms ACO-1 with K.C.C. within 90 days of well completion, following instructions on ACO-1, side 1, and including copies of wireline logs.
4. Notify District office 48 hours prior to old well workover or re-entry.
5. Prior to plugging, prepare a plugging plan, then obtain agreement from the appropriate district office for an approved plugging plan.
6. Submit plugging report (CP-4) to K.C.C. after plugging is completed.
7. Obtain an approved injection docket number before disposing of salt water.
8. Notify K.C.C. within 10 days when injection commences or terminates.
9. If an alternate 2 completion, cement in the production pipe from below any usable water to surface within 120 days of spud date.

State Corporation Commission of Kansas
Conservation Division
200 Colorado Derby Building
Wichita, Kansas 67202
(316) 263-3238