

CARD MUST BE TYPED

State of Kansas
NOTICE OF INTENTION TO DRILL
(see rules on reverse side)

CARD MUST BE SIGNED

Starting Date: April 15 1985
month day year

API Number 15- 037-21,321-0000

OPERATOR: License # 5602

W/2 NW
N ¹/₄ of SW ¹/₄ Sec 29 Twp 27S S, Rge 22E East
(location) West

Name N. & B. Enterprises

Address P.O. Box 884

City/State/Zip Chanute, Ks. 66720

Contact Person Edd Noland

Phone 431-9210

1980 Ft North from Southeast Corner of Section
5060 Ft West from Southeast Corner of Section
(Note: Locate well on Section Plat on reverse side)

CONTRACTOR: License # 5677

Nearest lease or unit boundary line 220 feet.

Name J.R. Burris Drilling

County Crawford

City/State P.O. Box 345 Iola, Ks. 66749

Lease Name Chas. Gier Well# 1

Well Drilled For: Well Class: Type Equipment:

- Oil Swd Infield Mud Rotary
- Gas Inj Pool Ext. Air Rotary
- OWWO Expl Wildcat Cable

- Domestic well within 330 feet: yes no
- Municipal well within one mile: yes no

If OWWO: old well info as follows:

Operator

Well Name

Comp Date Old Total Depth

Projected Total Depth 700 feet

Projected Formation at TD

Expected Producing Formations

Depth to Bottom of fresh water feet
 Lowest usable water formation
 Depth to Bottom of usable water 100 feet
 Surface pipe by Alternate: 1 2
 Surface pipe to be set 20 feet
 Conductor pipe if any required feet
 Ground surface elevation feet MSL
 This Authorization Expires 10-11-85
 Approved By Edd Noland

I certify that we will comply with K.S.A. 55-101, et seq., plus eventually plugging hole to K.C.C. specifications.

Date 4/10 Signature of Operator or Agent

Edd Noland

Title

Partner

W/2 NW 1/4 29-27S-22E

Must be filed with the K.C.C. five (5) days prior to commencing well
This card void if drilling not started within six (6) months of date received by K.C.C.

4-11-85


RECEIVED
STATE CORPORATION COMMISSION

Important procedures to follow:

APR 11 1985

A Regular Section of Land

1 Mile = 5,280 Ft.

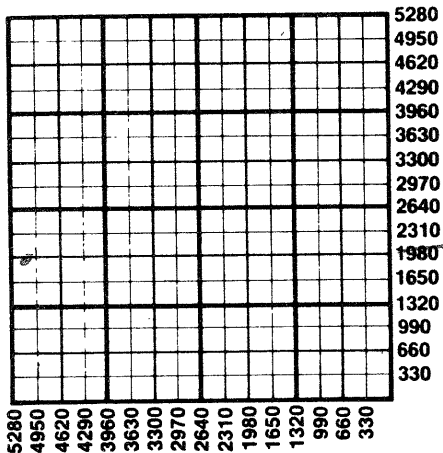

1. Notify District office before setting surface casing.
2. Set surface casing by circulating cement to the top.
3. File completion forms ACO-1 with K.C.C. within 90 days of well completion, following instructions on ACO-1, side 1, and including copies of wireline logs.
4. Notify District office 48 hours prior to old well workover or re-entry.
5. Prior to plugging, prepare a plugging plan, then obtain agreement from the appropriate district office for an approved plugging plan.
6. Submit plugging report (CP-4) to K.C.C. after plugging is completed.
7. Obtain an approved injection docket number before disposing of salt water.
8. Notify K.C.C. within 10 days when injection commences or terminates.
9. If an alternate 2 completion, cement in the production pipe from below any usable water to surface within 120 days of spud date.

CONSERVATION DIVISION
Wichita, Kansas

State Corporation Commission of Kansas
Conservation Division
200 Colorado Derby Building
Wichita, Kansas 67202
(316) 263-3238