

R

STATE OF KANSAS
STATE CORPORATION COMMISSION


WELL PLUGGING RECORD

Give All Information Completely
Make Required Affidavit
Mail or Deliver Report to:
Conservation Division
State Corporation Commission
211 No. Broadway
Wichita, Kansas

Greenwood County, Sec. 22 Twp. 23 Rge. 10 (E) (W)

Location as "NE/CNW/SW" or footage from line 90' E of SE SW NE
Lease Owner Viva Oil Co.
Lease Name Edwards Well No. 5
Office Address Box 185 - Eldorado, Kansas
Character of Well (completed as Oil, Gas or Dry Hole) dry hol
Date well completed 10/4/69 19
Application for plugging filed 10/4/69 19
Application for plugging approved 10/4/69 19
Plugging commenced 10/4/69 19
Plugging completed 10/4/69 19
Reason for abandonment of well or producing formation No producing formation found

NORTH

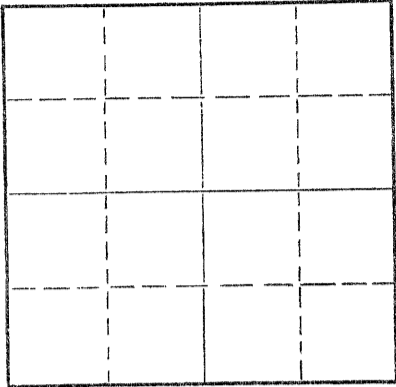

Locate well correctly on above
Section Plat

If a producing well is abandoned, date of last production - 19
Was permission obtained from the Conservation Division or its agents before plugging was commenced? yes

Name of Conservation Agent who supervised plugging of this well Marvin Corkery
Producing formation - Depth to top - Bottom - Total Depth of Well 2290 Feet
Show depth and thickness of all water, oil and gas formations.

OIL, GAS OR WATER RECORDS

CASING RECORD

FORMATION	CONTENT	FROM	TO	SIZE	PUT IN	PULLED OUT
Douglass Sand	water	1176	1278	7 5/8"	138'	0'


Describe in detail the manner in which the well was plugged, indicating where the mud fluid was placed and the method or methods used in introducing it into the hole. If cement or other plugs were used, state the character of same and depth placed, from - feet to - feet for each plug set.

Filled with rotary mud from T.D. to 220' and set bridge plug consisting of burlap bags and cottonseed hulls at 220' and cemented with 12 sacks cement.
Filled hole with rotary mud to 35' and set bridge plug as above and cemented with 6 sacks cement and filled rat hole with 2 sacks cement.

RECEIVED
STATE CORPORATION COMMISSION
10-17-69
OCT 7 1969
CONSERVATION DIVISION
Wichita, Kansas

(If additional description is necessary, use BACK of this sheet)
Name of Plugging Contractor Jackman & Jackman
Address c/p Pat Murphy Madison, Kansas

STATE OF Kansas COUNTY OF Greenwood, ss.
C. R. McClelland (employee of owner) or (owner or operator) of the above-described well being first duly sworn on oath, says: That I have knowledge of the facts, statements, and matters herein contained and the log of the above-described well, as filed and that the same are true and correct. So help me God.

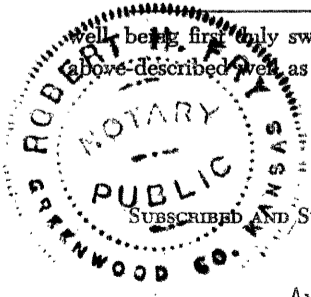

(Signature) C.R. McClelland

(Address)

SUBSCRIBED AND SWORN TO before me this 6 day of October, 19 69

My commission expires August 29, 1971

Robert H. Dry
Notary Public.

15-073-20469-00-8D

Well Log

Operator: Wva Oil Co.

Well Name:

Location: 290' S of SE SW NE 22 23 10 Greenwood County, Kansas

Commenced: Sept. 29, 1969

Completed: October 4, 1969

Casing: 138' of 7-5/8" casing cemented with 15 sacks.

Drilled by: Jackman & Jackman

Production: Dry

Total Depth: 2290'

Shale	0	12
Lime	12	16
Shale & Lime	16	138
Lime & shale	138	150
Lime & shale	150	440
Shale & shale	440	715
Lime & shale	715	1176
Water sand	1176	1278
Lime	1278	1443
Shale	1443	1561
Lime	1561	1735
Shale & shale	1735	2290

RECEIVED
 STATE CORPORATION COMMISSION
 10/7/69
 OCT 7 1969
 CONSERVATION DIVISION
 Wichita, Kansas

0' is 1' above ground level