


15-073-19515-00-01

STATE OF KANSAS
STATE CORPORATION COMMISSION

Give All Information Completely
Make Required Affidavit
Mail or Deliver Report to:
Conservation Division
State Corporation Commission
211 No. Broadway
Wichita, Kansas

WELL PLUGGING RECORD

NORTH

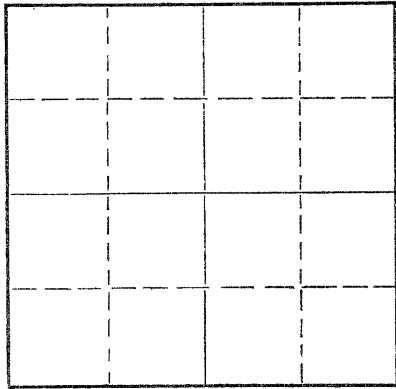

Locate well correctly on above
Section Plat

Greenwood County. Sec. 22 Twp. 23 Rge. 10 (E) E (W)
Location as "NE/CNW/SW" or footage from lines NW SE NW
Lease Owner Ward A. McGinnis
Lease Name Tom Edwards Well No. 1
Office Address 111 W. 4th, Eureka, Kansas
Character of Well (completed as Oil, Gas or Dry Hole) Dry Hole
Date well completed October 22 19 58
Application for plugging filed October 22 19 58
Application for plugging approved November 5 19 58
Plugging commenced October 22 19 58
Plugging completed October 22 19 58
Reason for abandonment of well or producing formation Dry Hole

If a producing well is abandoned, date of last production 19
Was permission obtained from the Conservation Division or its agents before plugging was commenced? yes

Name of Conservation Agent who supervised plugging of this well W. H. Lloyd, Hamilton, Kansas
Producing formation Depth to top Bottom Total Depth of Well 2134 Feet
Show depth and thickness of all water, oil and gas formations.

OIL, GAS OR WATER RECORDS

CASING RECORD

FORMATION	CONTENT	FROM	TO	SIZE	PUT IN	PULLED OUT

RECEIVED
STATE CORPORATION COMMISSION
NOV 7 1958
CONSERVATION DIVISION
Wichita, Kansas

Describe in detail the manner in which the well was plugged, indicating where the mud fluid was placed and the method or methods used in introducing it into the hole. If cement or other plugs were used, state the character of same and depth placed, from feet to feet for each plug set.

Filled with mud to 140' of surface - 15 sacks cement
Filled with mud to 18' of surface - 5 sacks cement
Filled with mud to surface - 5 sacks cement

RECEIVED
STATE CORPORATION COMMISSION
NOV 7 1958
CONSERVATION DIVISION
Wichita, Kansas

(If additional description is necessary, use BACK of this sheet)
Name of Plugging Contractor Greenwood Petroleum Management, Inc.
Address 111 W. 4th Street, Eureka, Kansas

STATE OF Kansas, COUNTY OF Greenwood, ss.
Ward A. McGinnis (signature) or (owner or operator) of the above-described well, being first duly sworn on oath, says: That I have knowledge of the facts, statements, and matters herein contained and the log of the above-described well as filed and that the same are true and correct. So help me God.

(Signature) Ward A. McGinnis
111 W. 4th Street, Eureka, Kansas (Address)

SUBSCRIBED AND SWORN TO before me this 6th day of November, 19 58

My commission expires October 26, 1959 Nelle M. Kirkpatrick Notary Public.

PLUGGING
FILE SEC 22 T. 23 R. 10E
BOOK PAGE 142 LINE 14