


STATE OF KANSAS
STATE CORPORATION COMMISSION

Give All Information Completely
Make Required Affidavit
Mail or Deliver Report to:
Conservation Division
State Corporation Commission
211 No. Broadway
Wichita, Kansas

WELL PLUGGING RECORD

15-073-19512 - 00-00

NORTH

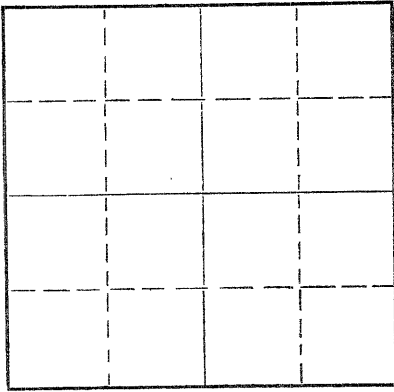

Locate well correctly on above
Section Plat

Greenwood County. Sec. 22 Twp. 23 Rge. 10 (E) #E(W)

Location as "NE/CNW&SW&" or footage from lines SW SE NW

Lease Owner Ward A. McGinnis

Lease Name Tom Edwards Well No. 3

Office Address 114 W. 4th, Eureka, Kansas

Character of Well (completed as Oil, Gas or Dry Hole) Dry Hole

Date well completed July 23 19 63

Application for plugging filed July 23 19 63

Application for plugging approved July 29 19 63

Plugging commenced July 23 19 63

Plugging completed July 23 19 63

Reason for abandonment of well or producing formation Dry Hole

If a producing well is abandoned, date of last production 19

Was permission obtained from the Conservation Division or its agents before plugging was commenced? yes

Name of Conservation Agent who supervised plugging of this well Marvin Corkery, Toronto, Kansas

Producing formation Depth to top Bottom Total Depth of Well 2180 Feet

Show depth and thickness of all water, oil and gas formations.

OIL, GAS OR WATER RECORDS

CASING RECORD

FORMATION	CONTENT	FROM	TO	SIZE	PUT IN	PULLED OUT

Describe in detail the manner in which the well was plugged, indicating where the mud fluid was placed and the method or methods used in introducing it into the hole. If cement or other plugs were used, state the character of same and depth placed, from feet to feet for each plug set.

Filled hole with mud to 240' Set plug w/15 sacks cement
Filled hole with mud to 47' Set Plug w/10 sacks cement
3 sacks cement in rat hole

RECEIVED
STATE CORPORATION COMMISSION
8/1/63
AUG 1 1963

CONSERVATION DIVISION
Wichita, Kansas

(If additional description is necessary, use BACK of this sheet)

Name of Plugging Contractor Greenwood Petroleum and Ranch Management, Inc.

Address 114 W. 4th, Eureka, Kansas

STATE OF Kansas, COUNTY OF Greenwood, ss.

Ward A. McGinnis (employee of owner) or (owner or operator) of the above-described well, being first duly sworn on oath, says: That I have knowledge of the facts, statements, and matters herein contained and the log of the above-described well as filed and that the same are true and correct. So help me God.

(Signature) Ward A. McGinnis

114 W. 4th, Eureka, Kansas

(Address)

SUBSCRIBED AND SWORN TO before me this 31st day of July 19 63

My commission expires February 8, 1964.

Notary Public.

15-073-19512-00-00

LOG OF WELL

TOM MINER NO. 3

LOCATION: SW SE NW Section 22-23-10E
Greenwood County, Kansas
ROTARY COMMENCED: July 18, 1963
ROTARY COMPLETED: July 23, 1963
TOTAL DEPTH: 2180
DRY HOLE

OWNER: WARD A. MCINNIS
DRILLED BY: GREENWOOD PETROLEUM AND
RANCH MANAGEMENT, INC.

FIGURES INDICATE ROTARY MEASUREMENT

9" surface hole line & shale	0	205	Set 200' x surface pipe w/ 60
line and shale	205	1105	sacks cement-pump plug to
Sand	1105	1228	190'
line	1228	1400	
Shale	1400	1485	
line	1485	1600	
line and shale	1600	1955	
Shale and shells	1955	2115	
Core #1 Cut 39' Rec. 39'			
sand - no oil	2115	2154	
Core #2 Cut 26' Shale	2154	2180	
TOTAL DEPTH	2180		

Plugging Record:

Filled hole with mud to 240' Set plug w/ 15 sacks cement
Filled hole with mud to 47' Set plug w/ 10 sacks cement
3 sacks cement in rat hole

RECEIVED
STATE CORPORATION COMMISSION
8/1/63
AUG 1 1963

CONSERVATION DIVISION
Wichita, Kansas