

15-073-00208-06

Form CP-4



STATE OF KANSAS  
STATE CORPORATION COMMISSION

Give All Information Completely  
Make Required Affidavit  
Mail or Deliver Report to:  
Conservation Division  
State Corporation Commission  
212 No. Market  
Wichita, Kansas

WELL PLUGGING RECORD

Greenwood County. Sec. 22 Twp. 23 Rge. 10 (E) (W)

Location as "NE/CNW/SW" or footage from lines SW SW SW

Lease Owner Rodney Dimick

Lease Name Pearson Well No. 1

Office Address Hamilton, Kansas

Character of Well (completed as Oil, Gas or Dry Hole) oil

Date well completed Jan. 1959 19

Application for plugging filed Aug. 28, 1970 19

Application for plugging approved Sept. 1970 19


Plugging commenced Sept. 10, 1970 19

Plugging completed Sept. 21, 1970 19

Reason for abandonment of well or producing formation depleted

If a producing well is abandoned, date of last production \_\_\_\_\_ 19

Was permission obtained from the Conservation Division or its agents before plugging was commenced? yes

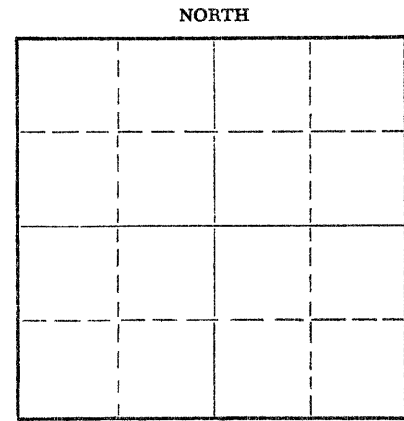

Locate well correctly on above Section Plat

Name of Conservation Agent who supervised plugging of this well Marvin Corkery

Producing formation \_\_\_\_\_ Depth to top \_\_\_\_\_ Bottom \_\_\_\_\_ Total Depth of Well 2345 Feet

Show depth and thickness of all water, oil and gas formations.


OIL, GAS OR WATER RECORDS

CASING RECORD

| FORMATION | CONTENT | FROM | TO | SIZE   | PUT IN  | PULLED OUT |
|-----------|---------|------|----|--------|---------|------------|
|           |         |      |    | 4 1/2" | 848 ft. |            |
|           |         |      |    |        |         |            |
|           |         |      |    |        |         |            |
Describe in detail the manner in which the well was plugged, indicating where the mud fluid was placed and the method or methods used in introducing it into the hole. If cement or other plugs were used, state the character of same and depth placed, from \_\_\_\_\_ feet to \_\_\_\_\_ feet for each plug set.

Bridged hole at 2200', rocks and dumped 3 sacks cement.  
Pulled casing, bridged hole at 180', rocks and 12 sacks cement to top.  
Rock bridge at 50 ft. ricks and 3 sacks cement to top.

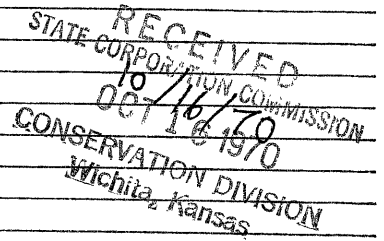

(If additional description is necessary, use BACK of this sheet)

Name of Plugging Contractor \_\_\_\_\_

Address \_\_\_\_\_

STATE OF Kansas COUNTY OF Greenwood, ss.

(employee of owner) or (owner or operator) of the above-described well, being first duly sworn on oath, says: That I have knowledge of the facts, statements, and matters herein contained and the log of the above-described well as filed and that the same are true and correct. So help me God.

(Signature) [Signature]

(Address) Hamilton, Kansas

SUBSCRIBED AND SWORN TO before me this 15th day of Oct, 1970

[Signature]  
Notary Public.

My commission expires 7-23-72

**EUREKA DRILLING CO.**  
 ROTARY TOOLS  
 HAMILTON, KANSAS

Company: A. W. Throgmorton  
 Farm: Pearson  
 Well: #1  
 Location: SW SW SW 22-23-10-Greenwood County  
 Contractor: Eureka Drilling Company  
 Date: Commenced Jan. 23. completed Jan. 28, 1959.

RECEIVED  
 STATE CORPORATION COMMISSION  
 8/31/70  
 AUG 31 1970  
 CONSERVATION DIVISION  
 Wichita, Kansas

Figures indicate bottoms of formations:-

|      |                              |
|------|------------------------------|
| 65   | lime                         |
| 685  | lime and shale               |
| 1175 | shale and lime               |
| 1325 | lime and shale               |
| 1475 | lime                         |
| 1685 | lime                         |
| 1765 | lime w/shale strks           |
| 1895 | shale and lime               |
| 2195 | lime and shale               |
| 2210 | sand and shale               |
| 2257 | sandy shale                  |
| 2292 | core #1 sand and shale S. O. |
| 2345 | shale and lime               |
| 2345 | RTD                          |

105' - 8" Surface casing  
 cemented to top

2338' - 4 1/2" O.A. 9 1/2" casing  
 cemented w/ 80 sks.