


WELL PLUGGING RECORD

Give All Information Completely
Make Required Affidavit
Mail or Deliver Report to:
Conservation Division
State Corporation Commission
211 No. Broadway
Wichita, Kansas

NORTH

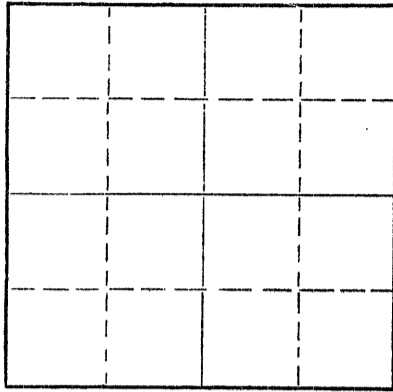

Locate well correctly on above
Section Plat

Rooks County, Sec. 32 Twp. 8 Rge. 17 (E) W (W)
Location as "NE/CNW/SW" or footage from lines SW NE SE
Lease Owner Fender Pipe & Supply, Inc.
Lease Name Brown "E" Well No. 2
Office Address Russell, Kansas
Character of Well (completed as Oil, Gas or Dry Hole) _____
Date well completed _____ 19____
Application for plugging filed _____ 19____
Application for plugging approved _____ 19____
Plugging commenced 1-6-65 _____ 19____
Plugging completed 1-18-65 _____ 19____
Reason for abandonment of well or producing formation Depleted.

If a producing well is abandoned, date of last production _____ 19____
Was permission obtained from the Conservation Division or its agents before plugging was commenced? yes

Name of Conservation Agent who supervised plugging of this well Eldon Petty
Producing formation _____ Depth to top _____ Bottom _____ Total Depth of Well 3414 Feet
Show depth and thickness of all water, oil and gas formations.

OIL, GAS OR WATER RECORDS

CASING RECORD

FORMATION	CONTENT	FROM	TO	SIZE	PUT IN	PULLED OUT
				8-5/8"	196'	None
				5-1/2"	3409'	1033'

Describe in detail the manner in which the well was plugged, indicating where the mud fluid was placed and the method or methods used in introducing it into the hole. If cement or other plugs were used, state the character of same and depth placed, from _____ feet to _____ feet for each plug set.

Checked hole to 3320', sanded hole to 3180' and dumped 5 sacks of cement @ 3180' with dump bailer. Pulled 5 1/2" casing to 550', circulated with 16 sacks of gel mud and pumped 20 sacks of cement @ 550'. Pulled 5 1/2" casing to 180' and pumped 20 sacks of cement. Pulled balance of 5 1/2" casing and capped well with 10 sacks of cement.

RECEIVED
STATE CORPORATION COMMISSION

PLUGGING COMPLETE

FEB 2 1965
2/2/65
CONSERVATION DIVISION
Wichita, Kansas

Name of Plugging Contractor KNIGHT CASING PULLING COMPANY
Address CHASE, KANSAS

STATE OF KANSAS, COUNTY OF RICE, ss.
Noel J. Knight

(employee of owner) or (owner or operator) of the above-described well, being first duly sworn on oath, says: That I have knowledge of the facts, statements, and matters herein contained and the log of the above-described well as filed and that the same are true and correct. So help me God.

(Signature) Noel J. Knight
Chase, Kansas
(Address)

SUBSCRIBED AND SWORN TO before me this 28th day of January, 1965

My commission expires May 20, 1968

Milton J. Volin
Notary Public.

15-163-02993-00-00


WELL LOG BUREAU—KANSAS GEOLOGICAL SOCIETY
508 East Murdock, Wichita, Kansas

Company- PETROLEUM, INC.
Farm- BROWN WEP No. 2

SEC. 32 T. 8 R. 17
SW NE SE

Total Depth 3414'
Comm. 1-30-54 Comp. 2-18-54
Shales Present
Contractor- Harvey Drilling Co.
Issued. 4-17-54

County Rooks KANSAS

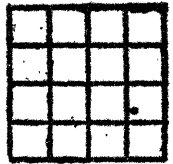

CASING:
8 5/8" 196' w/150 sxc Cem.
5 1/2" 3409' w/50 sxc Cem.

Elevation. 1980' B.B.

Production. Arbuckle - 53 bbls & 2% wtr

Figures Indicate Bottom of Formations.

rock & clay	115
shale & shells	860
sand	1005
shale & shells	1300
anhydrite	1336
shale & shells	1885
lime & shale	1940
lime	2265
lime & shale	2520
shale & shells	2620
lime & shale	2905
lime	3414
Total Depth	

TOPS:
Heebner 3106
Toronto 3125
Lansing 3404
Arbuckle 3404

RECEIVED
STATE CORPORATION COMMISSION

FEB 2 1965

CONSERVATION DIVISION
Wichita, Kansas

2/2/65