

STATE CORPORATION COMMISSION OF KANSAS
OIL & GAS CONSERVATION DIVISION

WELL COMPLETION OR RECOMPLETION FORM
ACO-1 WELL HISTORY

DESCRIPTION OF WELL AND LEASE

Operator: License # 5635
Name The Gene Brown Company
Address 407 S. Main
City/State/Zip Plainville, KS 67663

Purchaser

Operator Contact Person Thomas E. Brown
Phone 913-434-4811

Contractor: License # 9087
Name R. & C. Drilling Co., Inc.

Wellsite Geologist Anthony Kruse
Phone 913-628-2993

Designate Type of Completion
 New Well Re-Entry Workover
 Oil SWD Temp Abd
 Gas Inj Delayed Comp.
 Dry Other (Core, Water Supply etc.)

If OWNO: old well info as follows:
Operator
Well Name
Comp. Date Old Total Depth

WELL HISTORY

Drilling Method:
 Mud Rotary Air Rotary Cable
6-24-85 6-29-85 6-29-85
Spud Date Date Reached TD Completion Date
3405'
Total Depth PBTD

Amount of Surface Pipe Set and Cemented at 218' feet
Multiple Stage Cementing Collar Used? Yes No
If yes, show depth set feet
If alternate 2 completion, cement circulated from feet depth to w/ SX cmt


API NO. 15-163-22-694 00-00
County Rooks
C-S/2 SW NW Sec. 32 Twp. 8 Rge. 17 East West

2970 Ft North from Southeast Corner of Section
4620 Ft West from Southeast Corner of Section
(Note: Locate well in section plat below)

Lease Name Stamper Well # 3
Field Name Dopita

Producing Formation
Elevation: Ground 1970 KB 1975

Section Plat

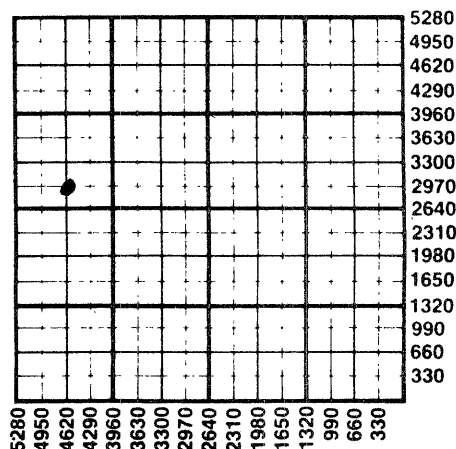

WATER SUPPLY INFORMATION

Disposition of Produced Water: Disposal
Docket # Repressuring
John Russ, P.O. Box 187, Stockton, KS 67669

Questions on this portion of the ACO-1 call:
Water Resources Board (913) 296-3717

Source of Water:
Division of Water Resources Permit #

Groundwater Ft North from Southeast Corner (Well) Ft West from Southeast Corner of Sec Twp Rge East West
 Surface Water 4850 Ft North from Southeast Corner (Stream, pond etc) 4950 Ft West from Southeast Corner Sec 31 Twp 8 Rge 17 East West
 Other (explain) (purchased from city, R.W.D. #)

INSTRUCTIONS: This form shall be completed in duplicate and filed with the Kansas Corporation Commission, 200 Colorado Derby Building, Wichita, Kansas 67202, within 90 days after completion or recompletion of any well. Rule 82-3-130 and 82-3-107 apply. Information on side two of this form will be held confidential for a period of 12 months if requested in writing and submitted with the form. See rule 82-3-107 for confidentiality in excess of 12 months. One copy of all wireline logs and drillers time log shall be attached with this form. Submit CP-4 form with all plugged wells. Submit CP-111 form with all temporarily abandoned wells.

All requirements of the statutes, rules and regulations promulgated to regulate the oil and gas industry have been fully complied with and the statements herein are complete and correct to the best of my knowledge.

Signature John Weis
Title Tool Pusher Date 7-1-85

Subscribed and sworn to before me this 1st day of July 1985
Notary Public Karen Randa
Date Commission Expires 5-14-88



K.C.C. OFFICE USE ONLY
F Letter of Confidentiality Attached
C Wireline Log Received
C Drillers Timelog Received
Distribution
 KCC SWD/Rep NGPA
 KGS Plug Other (Specify)

JUL 16 1985 7/16/85

Sec. 31 Twp. 8 Rge. 17

SIDE TWO

Operator Name The Gene Brown Company Lease Name Stamper Well # 3

Sec. 32 Twp. 8 Rge. 17 East West County Rooks

WELL LOG

INSTRUCTIONS: Show important tops and base of formations penetrated. Detail all cores. Report all drill stem tests giving interval tested, time tool open and closed, flowing and shut-in pressures, whether shut-in pressure reached static level, hydrostatic pressures, bottom hole temperature, fluid recovery, and flow rates if gas to surface during test. Attach extra sheet if more space is needed. Attach copy of log.

Drill Stem Tests Taken Yes No
 Samples Sent to Geological Survey Yes No
 Cores Taken Yes No

Formation Description
 Log Sample

0' - 218' Sand & Shale
 218' - 645' Chalk, Sand, & Shale
 645' - 1288' Sand & Shale
 1288' - 1320' Anhydrite
 1320' - 1566' Sand & Shale
 1320' - 1901' Sand, Shale, & Lime
 1901' - 3405' Lime & Shale R.T.D.

Name	Top	Bottom
Anhydrite	1288	1320
Topeka	2874	3088
Hebner	3088	3111
Toronto	3111	3129
Lansing	3129	3359
RTD		3405

CASING RECORD <input checked="" type="checkbox"/> New <input type="checkbox"/> Used							
Report all strings set-conductor, surface, intermediate, production, etc.							
Purpose of String	Size Hole Drilled	Size Casing Set (in O.D.)	Weight Lbs/Ft.	Setting Depth	Type of Cement	#Sacks Used	Type and Percent Additives
Surface	12 1/4	8 5/8	20	218	Class A	130	3%CC

PERFORATION RECORD		Acid, Fracture, Shot, Cement Squeeze Record	
Shots Per Foot	Specify Footage of Each Interval Perforated	(Amount and Kind of Material Used)	Depth

TUBING RECORD				Liner Run <input type="checkbox"/> Yes <input type="checkbox"/> No	
Size	Set At	Packer at			

Date of First Production	Producing Method <input type="checkbox"/> Flowing <input type="checkbox"/> Pumping <input type="checkbox"/> Gas Lift <input type="checkbox"/> Other (explain).....				
	Oil	Gas	Water	Gas-Oil Ratio	Gravity
Estimated Production Per 24 Hours	Bbls	MCF	Bbls	CFPB	

METHOD OF COMPLETION Production Interval

Disposition of gas: Vented Sold Used on Lease Open Hole Perforation Other (Specify).....
 Shut-in Completed Commingled