

CARD MUST BE TYPED

State of Kansas
NOTICE OF INTENTION TO DRILL
(see rules on reverse side)

CARD MUST BE SIGNED

Starting Date: 8 1 85
month day year

API Number 15- 207-25,353-00-00

OPERATOR: License # 5150
Name Mack C. Colt, Inc.
Address P.O. Box 388
City/State/Zip Iola, KS. 66749
Contact Person Dennis Kershner
Phone 316-365-3111

NE NW NE Sec 23 Twp 26 S, Rge 14
(location) X East
4670 Ft North from Southeast Corner of Section
1560 Ft West from Southeast Corner of Section
(Note: Locate well on Section Plat on reverse side)

CONTRACTOR: License #
Name company tools
City/State

Nearest lease or unit boundary line 420 feet.
County Woodson
Lease Name Lauber Well# 6A

Domestic well within 330 feet: yes no
Municipal well within one mile: yes no

Well Drilled For: Well Class: Type Equipment:
 Oil Swd Infield Mud Rotary
 Gas Inj Pool Ext. Air Rotary
 OWWO Expl Wildcat Cable

Depth to Bottom of fresh water 240 unknown feet
Lowest usable water formation unknown
Depth to Bottom of usable water 225 feet
Surface pipe by Alternate: 1 2
Surface pipe to be set 40 feet
Conductor pipe if any required none feet
Ground surface elevation unknown feet MSL
This Authorization Expires 1-29-86
Approved By 7-29-85 KC

If OWWO: old well info as follows:

Operator
Well Name
Comp Date Old Total Depth
Projected Total Depth 1300 feet
Projected Formation at TD Bartlesville
Expected Producing Formations Bartlesville

I certify that we will comply with K.S.A. 55-101, et seq., plus eventually plugging hole to K.C.C. specifications.

Date 7-26-85 Signature of Operator or Agent

Dennis Kershner Title Agent

Rec'd for KOHE

Must be filed with the K.C.C. five (5) days prior to commencing well
 This card void if drilling not started within six (6) months of date received by K.C.C.


7-29-85

RECEIVED
 STATE CORPORATION COMMISSION

Important procedures to follow:

ATTN-291985

**A Regular Section of Land
 1 Mile = 5,280 Ft.**

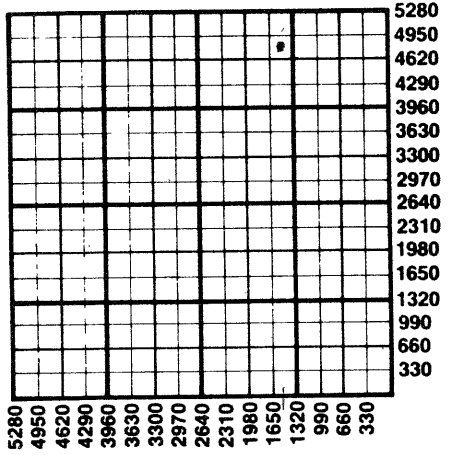

1. Notify District office before setting surface casing.
2. Set surface casing by circulating cement to the top.
3. File completion forms ACO-1 with K.C.C. within 90 days of well completion, following instructions on ACO-1, side 1, and including copies of wireline logs.
4. Notify District office 48 hours prior to old well workover or re-entry.
5. Prior to plugging, prepare a plugging plan, then obtain agreement from the appropriate district office for an approved plugging plan.
6. Submit plugging report (CP-4) to K.C.C. after plugging is completed.
7. Obtain an approved injection docket number before disposing of salt water.
8. Notify K.C.C. within 10 days when injection commences or terminates.
9. If an alternate 2 completion, cement in the production pipe from below any usable water to surface within 120 days of spud date.

CONSERVATION DIVISION
 Wichita, Kansas

**State Corporation Commission of Kansas
 Conservation Division
 200 Colorado Derby Building
 Wichita, Kansas 67202
 (316) 263-3238**