

CARD MUST BE TYPED

State of Kansas
NOTICE OF INTENTION TO DRILL
(see rules on reverse side)

CARD MUST BE SIGNED

Starting Date: 9 26 85
month day year

API Number 15- 207-25,392-00-00

OPERATOR: License # 5150.....
Name Mack C. Colt, Inc......
Address P.O. Box 388.....
City/State/Zip Iola, KS 66749.....
Contact Person Dennis Kershner.....
Phone 316-365-3111.....

NW SE NE Sec 24 Twp 26 S, Rge 14 East
(location) West

..... 3905 Ft North from Southeast Corner of Section
..... 1160 Ft West from Southeast Corner of Section
(Note: Locate well on Section Plat on reverse side)

CONTRACTOR: License # 5150.....
Name company tools.....
City/State

Nearest lease or unit boundary line 1000 feet.

County Woodson.....

Lease Name Lauber..... Well# 29A0.....

Domestic well within 330 feet : yes no

Municipal well within one mile : yes no

Well Drilled For: Well Class: Type Equipment:

- Oil Swd Infield Mud Rotary
- Gas Inj Pool Ext. Air Rotary
- OWWO Expl Wildcat Cable

Depth to Bottom of fresh water unknown 5100 feet

Lowest usable water formation unknown

Depth to Bottom of usable water 225 feet

Surface pipe by Alternate : 1 2

Surface pipe to be set 40 feet

Conductor pipe if any required none feet

Ground surface elevation unknown feet MSL

This Authorization Expires 3-23-86

Approved By 9-23-85 E

If OWWO: old well info as follows:

Operator

Well Name

Comp Date Old Total Depth

Projected Total Depth 1300 feet

Projected Formation at TD Bartlesville.....

Expected Producing Formations Bartlesville.....

I certify that we will comply with K.S.A. 55-101, et seq., plus eventually plugging hole to K.C.C. specifications.

Date 9-20-85 Signature of Operator or Agent


Dennis Kershner

Title Agent

Must be filed with the K.C.C. five (5) days prior to commencing well
 This card void if drilling not started within six (6) months of date received by K.C.C.

Important procedures to follow :

A Regular Section of Land
1 Mile = 5,280 Ft.

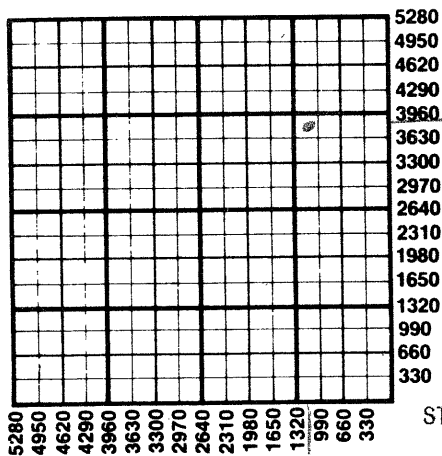

1. Notify District office before setting surface casing.
2. Set surface casing by circulating cement to the top.
3. File completion forms ACO-1 with K.C.C. within 90 days of well completion, following instructions on ACO-1, side 1, and including copies of wireline logs.
4. Notify District office 48 hours prior to old well workover or re-entry.
5. Prior to plugging, prepare a plugging plan, then obtain agreement from the appropriate district office for an approved plugging plan.
6. Submit plugging report (CP-4) to K.C.C. after plugging is completed.
7. Obtain an approved injection docket number before disposing of salt water.
8. Notify K.C.C. within 10 days when injection commences or terminates.
9. If an alternate 2 completion, cement in the production pipe from below any usable water to surface within 120 days of spud date.

RECEIVED

STATE CORPORATION COMMISSION

State Corporation Commission of Kansas

Conservation Division

200 Colorado Derby Building

Wichita, Kansas 67202

(316) 263-3238

SEP 23 1985

CONSERVATION DIVISION
 Wichita, Kansas

9-23-85