

CARD MUST BE TYPED

State of Kansas
NOTICE OF INTENTION TO DRILL
 (see rules on reverse side)

CARD MUST BE SIGNED

Starting Date: 08 05 84
 month day year

API Number 15- 207-24,947-00-00

OPERATOR: License # 9707

Name Kan-Tan Oil, Inc.

Address Route 4, Box 424

City/State/Zip Chanute, Kansas 66720

Contact Person Kenneth C. Keas

Phone 316-431-2414

CONTRACTOR: License # 5653

Name Osage Drilling, Inc.

City/State Chanute, Kansas 66720

SW NW NW Sec 34 Twp 26 S, Rge 14 ☒ East
 (location) ☐ West

4080 Ft North from Southeast Corner of Section

4920 Ft West from Southeast Corner of Section

(Note: Locate well on Section Plat on reverse side)

Nearest lease or unit boundary line 360 feet.

County Woodson

Lease Name Ferguson Well# 5

Domestic well within 330 feet : ☐ yes ☒ no

Municipal well within one mile : ☐ yes ☒ no

Depth to Bottom of fresh water 225.60 feet

Lowest usable water formation none

Depth to Bottom of usable water feet

Surface pipe by Alternate : 1 ☐ 2 ☒

Surface pipe to be set 40 feet

Conductor pipe if any required feet

Ground surface elevation 937 feet MSL

This Authorization Expires 1/1/85

Approved By J. H. Ballard

Well Drilled For: Well Class: Type Equipment:

☒ Oil ☐ Swd ☐ Infield ☒ Mud Rotary

☐ Gas ☐ Inj ☐ Pool Ext. ☐ Air Rotary

☐ OWWO ☐ Expl ☒ Wildcat ☐ Cable

If OWWO: old well info as follows:

Operator

Well Name

Comp Date Old Total Depth

Projected Total Depth 1400' feet

Projected Formation at TD Mississippi

Expected Producing Formations Bartlesville

I certify that we will comply with K.S.A. 55-101, et seq., plus eventually plugging hole to K.C.C. specifications.

Date 07-09-84 Signature of Operator or Agent J. H. Ballard Title Agent

Must be filed with the K.C.C. five (5) days prior to commencing well
This card void if drilling not started within six (6) months of date received by K.C.C.

7-11-84


Important procedures to follow

RECEIVED
STATE CORPORATION COMMISSION

JUL 11 1984

CONSERVATION DIVISION
Wichita, Kansas

A Regular Section of Land
1 Mile = 5,280 Ft.

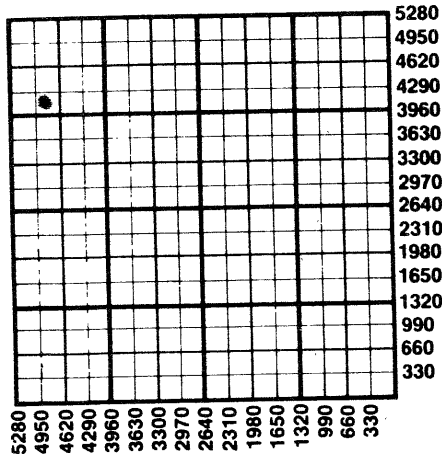

1. Notify District office before setting surface casing.
2. Set surface casing by circulating cement to the top.
3. File completion forms ACO-1 with K.C.C. within 90 days of well completion, following instructions on ACO-1, side 1, and including copies of wireline logs.
4. Notify District office 48 hours prior to old well workover or re-entry.
5. Prior to plugging, prepare a plugging plan, then obtain agreement from the appropriate district office for an approved plugging plan.
6. Submit plugging report (CP-4) to K.C.C. after plugging is completed.
7. Obtain an approved injection docket number before disposing of salt water.
8. Notify K.C.C. within 10 days when injection commences or terminates.
9. If an alternate 2 completion, cement in the production pipe from below any usable water to surface within 120 days of spud date.

State Corporation Commission of Kansas
Conservation Division
200 Colorado Derby Building
Wichita, Kansas 67202
(316) 263-3238