

CARD MUST BE TYPED

State of Kansas
NOTICE OF INTENTION TO DRILL
(see rules on reverse side)

CARD MUST BE SIGNED

Starting Date: 12 11 84
month day year

API Number 15- 207-25,180-0000

OPERATOR: License # 9985

NE.. SE.. NW Sec 29... Twp 26.. S, Rge 15.. East
(location) West

Name KANSA OIL L. P.

Address P.O. BOX 7668

City/State/Zip SHAWNEE MISSION, KS. 66207

Contact Person DENNIS KERSHNER

Phone 316-365-3111

3740 Ft North from Southeast Corner of Section
2970 Ft West from Southeast Corner of Section
(Note: Locate well on Section Plat on reverse side)

CONTRACTOR: License # 5150

Name MACK C. COLT, INC

City/State IOLA, KS. 66749

Nearest lease or unit boundary line 300 feet.

County WOODSON

Lease Name CLYDE HILL TRACT 1 Well# 1A0

Domestic well within 330 feet : yes no

Municipal well within one mile : yes no

Well Drilled For: Well Class: Type Equipment:

- Oil Swd Infield Mud Rotary
- Gas Inj Pool Ext. Air Rotary
- OWWO Expl Wildcat Cable

Depth to Bottom of fresh water UNKNOWN feet

Lowest usable water formation UNKNOWN feet

Depth to Bottom of usable water 225 feet

Surface pipe by Alternate: 1 2

Surface pipe to be set 40 feet

Conductor pipe if any required NONE feet

Ground surface elevation UNKNOWN feet MSL

This Authorization Expires 6-7-85

Approved By 12-7-84 *RC*

If OWWO: old well info as follows:

Operator

Well Name

Comp Date Old Total Depth

Projected Total Depth 1400 feet

Projected Formation at TD BARTLESVILLE

Expected Producing Formations BARTLESVILLE

I certify that we will comply with K.S.A. 55-101, et seq., plus eventually plugging hole to K.C.C. specifications.


Date Signature of Operator or Agent *Mack C. Colt, Inc* Title *Gen. Partner*

mhc/KOHE 12/2/84
Form C-1 4/84

**Must be filed with the K.C.C. five (5) days prior to commencing well
This card void if drilling not started within six (6) months of date received by K.C.C.**

Important procedures to follow :

**A Regular Section of Land
1 Mile = 5,280 Ft.**

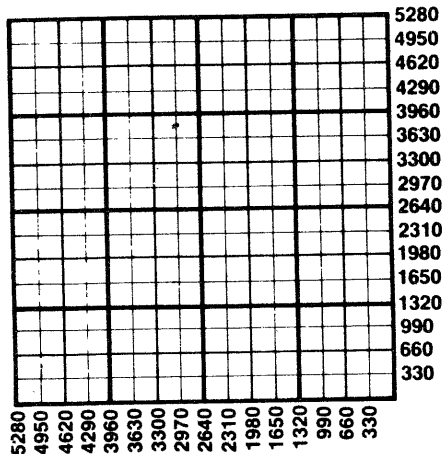

1. Notify District office before setting surface casing.
2. Set surface casing by circulating cement to the top.
3. File completion forms ACO-1 with K.C.C. within 90 days of well completion, following instructions on ACO-1, side 1, and including copies of wireline logs.
4. Notify District office 48 hours prior to old well workover or re-entry.
5. Prior to plugging, prepare a plugging plan, then obtain agreement from the appropriate district office for an approved plugging plan.
6. Submit plugging report (CP-4) to K.C.C. after plugging is completed.
7. Obtain an approved injection docket number before disposing of salt water.
8. Notify K.C.C. within 10 days when injection commences or terminates.
9. If an alternate 2 completion, cement in the production pipe from below any usable water to surface within 120 days of spud date.

12-7-84

RECEIVED
STATE CORPORATION COMMISSION

DEC 07 1984 State Corporation Commission of Kansas
Conservation Division

CONSERVATION DIVISION
Wichita, Kansas

200 Colorado Derby Building
Wichita, Kansas 67202
(316) 263-3238