

CARD MUST BE TYPED

State of Kansas NOTICE OF INTENTION TO DRILL

CARD MUST BE SIGNED

(see rules on reverse side)

Starting Date: 7 23 85
month day year

API Number 15- 207-25,347-00-00

OPERATOR: License # 9985
Name Kansa Oil L.P.
Address Box 7668
City/State/Zip Shawnee Mission, KS 66207
Contact Person Dennis Kershner
Phone 316-365-3111

NW NE SE Sec 29 Twp 26 S, Rge 15 East
(location) West

CONTRACTOR: License # 5150
Name Mack C. Colt, Inc.
City/State Iola, KS 66749

2140 Ft North from Southeast Corner of Section
1155 Ft West from Southeast Corner of Section
(Note: Locate well on Section Plat on reverse side)

Nearest lease or unit boundary line 165 feet.
County Woodson
Lease Name West. O'Bryan Well# 1A0

Well Drilled For: Well Class: Type Equipment:
 Oil Swd Infield Mud Rotary
 Gas Inj Pool Ext. Air Rotary
 OWWO Expl Wildcat Cable

Domestic well within 330 feet: yes no
Municipal well within one mile: yes no

Depth to Bottom of fresh water ~100 unknown feet
Lowest usable water formation Douglas Group
Depth to Bottom of usable water 225 feet

Surface pipe by Alternate: 1 2
Surface pipe to be set 40 feet
Conductor pipe if any required none feet
Ground surface elevation unknown feet MSL

This Authorization Expires 1-17-86
Approved By 7-17-85

If OWWO: old well info as follows:

Operator
Well Name
Comp Date Old Total Depth
Projected Total Depth 1400 feet
Projected Formation at TD Bartlesville
Expected Producing Formations Bartlesville


I certify that we will comply with K.S.A. 55-101, et seq., plus eventually plugging hole to K.C.C. specifications.

Date 7-16-85 Signature of Operator or Agent Mack C. Colt Title Contractor RCH for KOHE

Must be filed with the K.C.C. five (5) days prior to commencing well
This card void if drilling not started within six (6) months of date received by K.C.C.

Important procedures to follow :

**A Regular Section of Land
1 Mile = 5,280 Ft.**

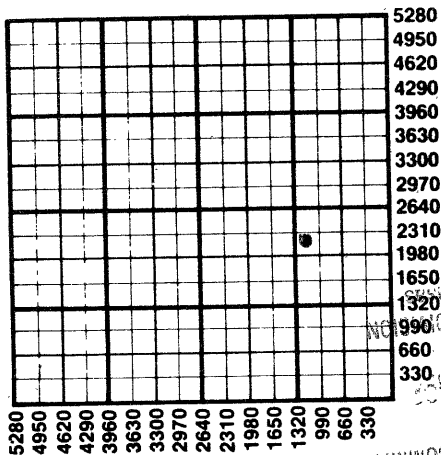

1. Notify District office before setting surface casing.
2. Set surface casing by circulating cement to the top.
3. File completion forms ACO-1 with K.C.C. within 90 days of well completion, following instructions on ACO-1, side 1, and including copies of wireline logs.
4. Notify District office 48 hours prior to old well workover or re-entry.
5. Prior to plugging, prepare a plugging plan, then obtain agreement from the appropriate district office for an approved plugging plan.
6. Submit plugging report (CP-4) to K.C.C. after plugging is completed.
7. Obtain an approved injection docket number before disposing of salt water.
8. Notify K.C.C. within 10 days when injection commences or terminates.
9. If an alternate 2 completion, cement in the production pipe from below any usable water to surface within 120 days of spud date.

STATE CORPORATION COMMISSION
RECEIVED
MICHIGAN, KANSAS CONSERVATION DIVISION
MAY 17 1988

58-85
7-17-88

**State Corporation Commission of Kansas
Conservation Division
200 Colorado Derby Building
Wichita, Kansas 67202
(316) 263-3238**