

CARD MUST BE SIGNED

API Number 15- 207- 24,968-0000

SE NE NE Sec 33 Twp 26 S, Rge 14 ☒ East
(location) ☐ West

.....4080..... Ft North from Southeast Corner of Section
165..... Ft West from Southeast Corner of Section
 (Note: Locate well on Section Plat on reverse side)

Nearest lease or unit boundary line165..... feet.

County Woodson

Lease Name Ferguson Well# 6

Domestic well within 330 feet : ☐ yes ☒ no

Municipal well within one mile : ☐ yes ☒ no

Depth to Bottom of fresh water 225..... feet

Lowest usable water formation none

Depth to Bottom of usable water 225 feet

Surface pipe by Alternate : 1 ☐ 2 ☒

Surface pipe to be set 40 feet

Conductor pipe to be set feet

Conductor pipe if any required **None** feet

Ground surface elevation _____ feet MSL

Ground surface elevation feet MSL
This Authorization Expires 11/25/25

This Authorization Expires
Approved By: 2/25/84

Approved By 12-10 

Operator	
Well Name	
Comp Date	Old Total Depth
Projected Total Depth	1400
Projected Formation at TD	Mississippi
Expected Producing Formations	Squirrel

I certify that we will comply with K.S.A. 55-101, et seq., plus eventually plugging hole to K.C.C. specifications.

Date 07-24-84 Signature of Operator or Agent _____

G. L. Bellard

Title Agênt

THC/KONE 1/25/99

Must be filed with the K.C.C. five (5) days prior to commencing well
This card void if drilling not started within six (6) months of date received by K.C.C.


7-25-84

RECEIVED
STATE CORPORATION COMMISSION

JUL 25 1984

CONSERVATION DIVISION
Wichita, Kansas

A Regular Section of Land
1 Mile = 5,280 Ft.

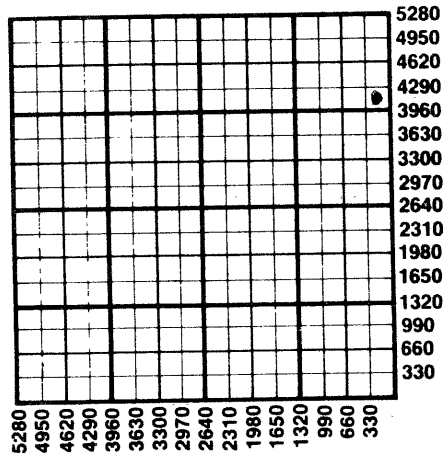

- Important procedures to follow:**
1. Notify District office before setting surface casing.
 2. Set surface casing by circulating cement to the top.
 3. File completion forms ACO-1 with K.C.C. within 90 days of well completion, following instructions on ACO-1, side 1, and including copies of wireline logs.
 4. Notify District office 48 hours prior to old well workover or re-entry.
 5. Prior to plugging, prepare a plugging plan, then obtain agreement from the appropriate district office for an approved plugging plan.
 6. Submit plugging report (CP-4) to K.C.C. after plugging is completed.
 7. Obtain an approved injection docket number before disposing of salt water.
 8. Notify K.C.C. within 10 days when injection commences or terminates.
 9. If an alternate 2 completion, cement in the production pipe from below any usable water to surface within 120 days of spud date.

State Corporation Commission of Kansas
Conservation Division
200 Colorado Derby Building
Wichita, Kansas 67202
(316) 263-3238