

CARD MUST BE TYPED

State of Kansas

CARD MUST BE SIGNED

### NOTICE OF INTENTION TO DRILL

(see rules on reverse side)

✓0

Starting Date ..... Sept. 25 1988  
month day year

API Number 15— 163-23,016 0000

OPERATOR: License # ..... 5537 .....

SW 32 SW SW Sec 32 Twp. 8 S, Rg. 17 X East West

Name .... Kenneth O. Brown .....

..... 620 ..... Ft. from South Line of Section

Address .. Drawer 340 .....

..... 4830 ..... Ft. from East Line of Section

City/State/Zip .... Plainville, Kansas 67663 .....

(Note: Locate well on Section Plat on reverse side)

Contact Person... Kenneth O. Brown .....

Nearest lease or unit boundary line ... 450 ..... feet

Phone ..... 913-434-7236 .....

County.... Rooks .....

CONTRACTOR: License # ..... 9087 .....

Lease Name.... Stamper ..... Well #. 1 .....

Name .. R. & C. Drilling, Inc. .....

Ground surface elevation ... 1264 ..... feet MSL

City/State... Hays, Kansas 67601 .....

Domestic well within 330 feet: \_\_\_\_\_ yes X no

Well Drilled For: Well Class: Type Equipment:

Municipal well within one mile: \_\_\_\_\_ yes X no

X Oil \_\_\_\_\_ SWD X Infield X Mud Rotary

Depth to bottom of fresh water... 70+100' .....

\_\_\_\_\_ Gas \_\_\_\_\_ Inj \_\_\_\_\_ Pool Ext. \_\_\_\_\_ Air Rotary

Depth to bottom of usable water ... 900' .....

\_\_\_\_\_ OWWO \_\_\_\_\_ Expl \_\_\_\_\_ Wildcat \_\_\_\_\_ Cable

Surface pipe by Alternate: \_\_\_\_\_ 1 \_\_\_\_\_ 2 X

IF OWWO: old well info as follows:

Surface pipe planned to be set ..... 200' .....

Operator .....

Conductor pipe required N/A .....

Well Name .....

Projected Total Depth ..... 3450 ..... feet

Comp Date ..... Old Total Depth.....

Formation... Arbuckle .....

I certify that well will comply with K.S.A. 55-101, et seq., plus eventually plugging hole to KCC specifications.

Date .. 8-17-88 ..... Signature of Operator or Agent Kenneth O. Brown ..... Title... Operator & Owner .....

For KCC Use:

Conductor Pipe Required ..... feet; Minimum Surface Pipe Required ..... 200' feet per Alt. X (2)

This Authorization Expires ..... 2-19-89 ..... Approved By LKM 8-19-88 .....


EFFECTIVE DATE: 8-24-88

Must be filed with the K.C.C. five (5) days prior to commencing well  
This card void if drilling not started within six (6) months of date received by K.C.C.

### Important procedures to follow:

1. Notify District office before setting surface casing.
2. Set surface casing by circulating cement to the top.
3. File completion forms ACO-1 with K.C.C. within 90 days of well completion, following instructions on ACO-1, side 1, and including copies of wireline logs.
4. Notify District office 48 hours prior to old well workover or re-entry.
5. Prior to filing Intent, prepare a proposed plugging plan in case well is D & A, then obtain approval of plan when calling district office prior to setting surface pipe.
6. Submit plugging report (CP-4) to K. C. C. after plugging is completed.
7. Obtain an approved injection docket number before disposing of salt water.
8. Notify K.C.C. within 10 days when injection commences or terminates.
9. If an alternate 2 completion, cement in the production pipe from below any usable water to surface within 120 days of spud date.

### A Regular Section of Land 1 Mile = 5,280 Ft.

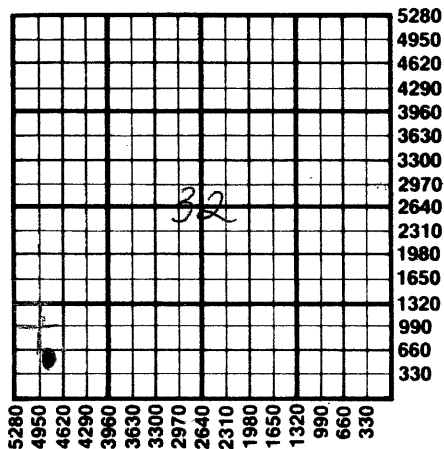

State Corporation Commission of Kansas  
Conservation Division  
200 Colorado Derby Building  
Wichita, Kansas 67202  
(316) 263-3238